


KING SURVEYORS, INC. 650 GARDEN DR. WINDSOR, CO 80550

Location Drawing

SECTION: 12
TOWNSHIP: 2S
RANGE: 45W

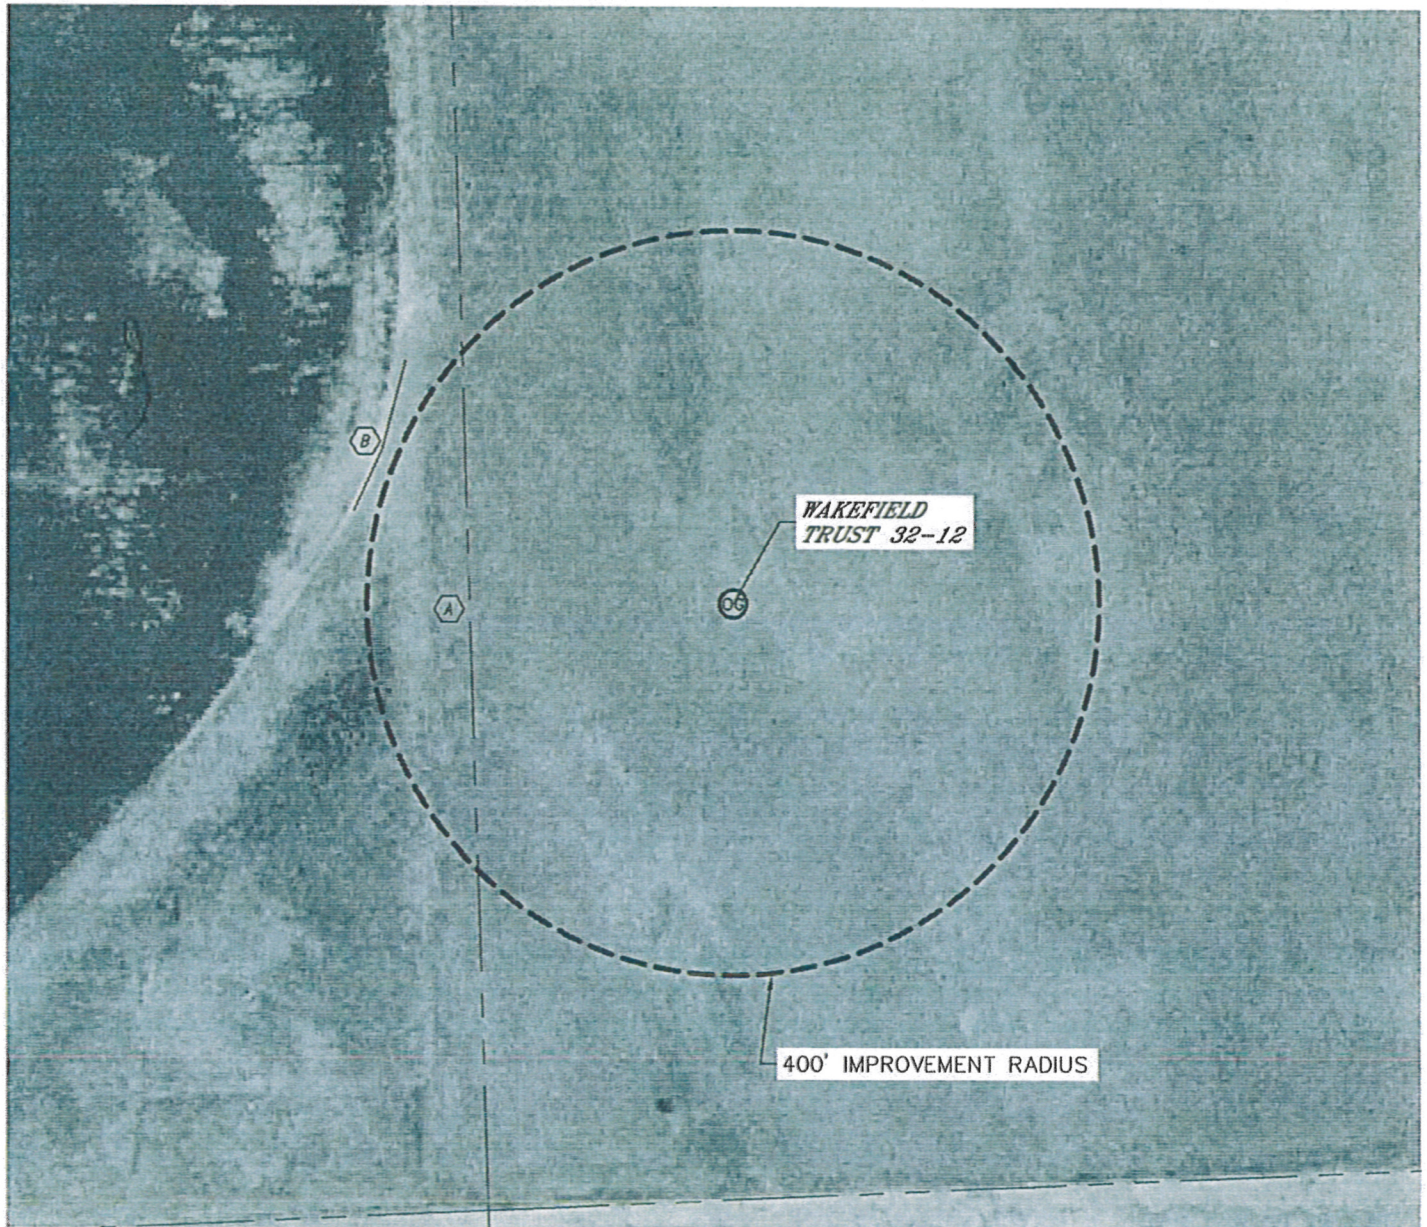

IMPROVEMENTS:

- (A) PROPERTY LINE 288' WEST
- (B) FIELD LINE 418' NORTHWEST

