



# Hellzapoppin 24-32 TR (Arrowhead Ranchette Subdivision)

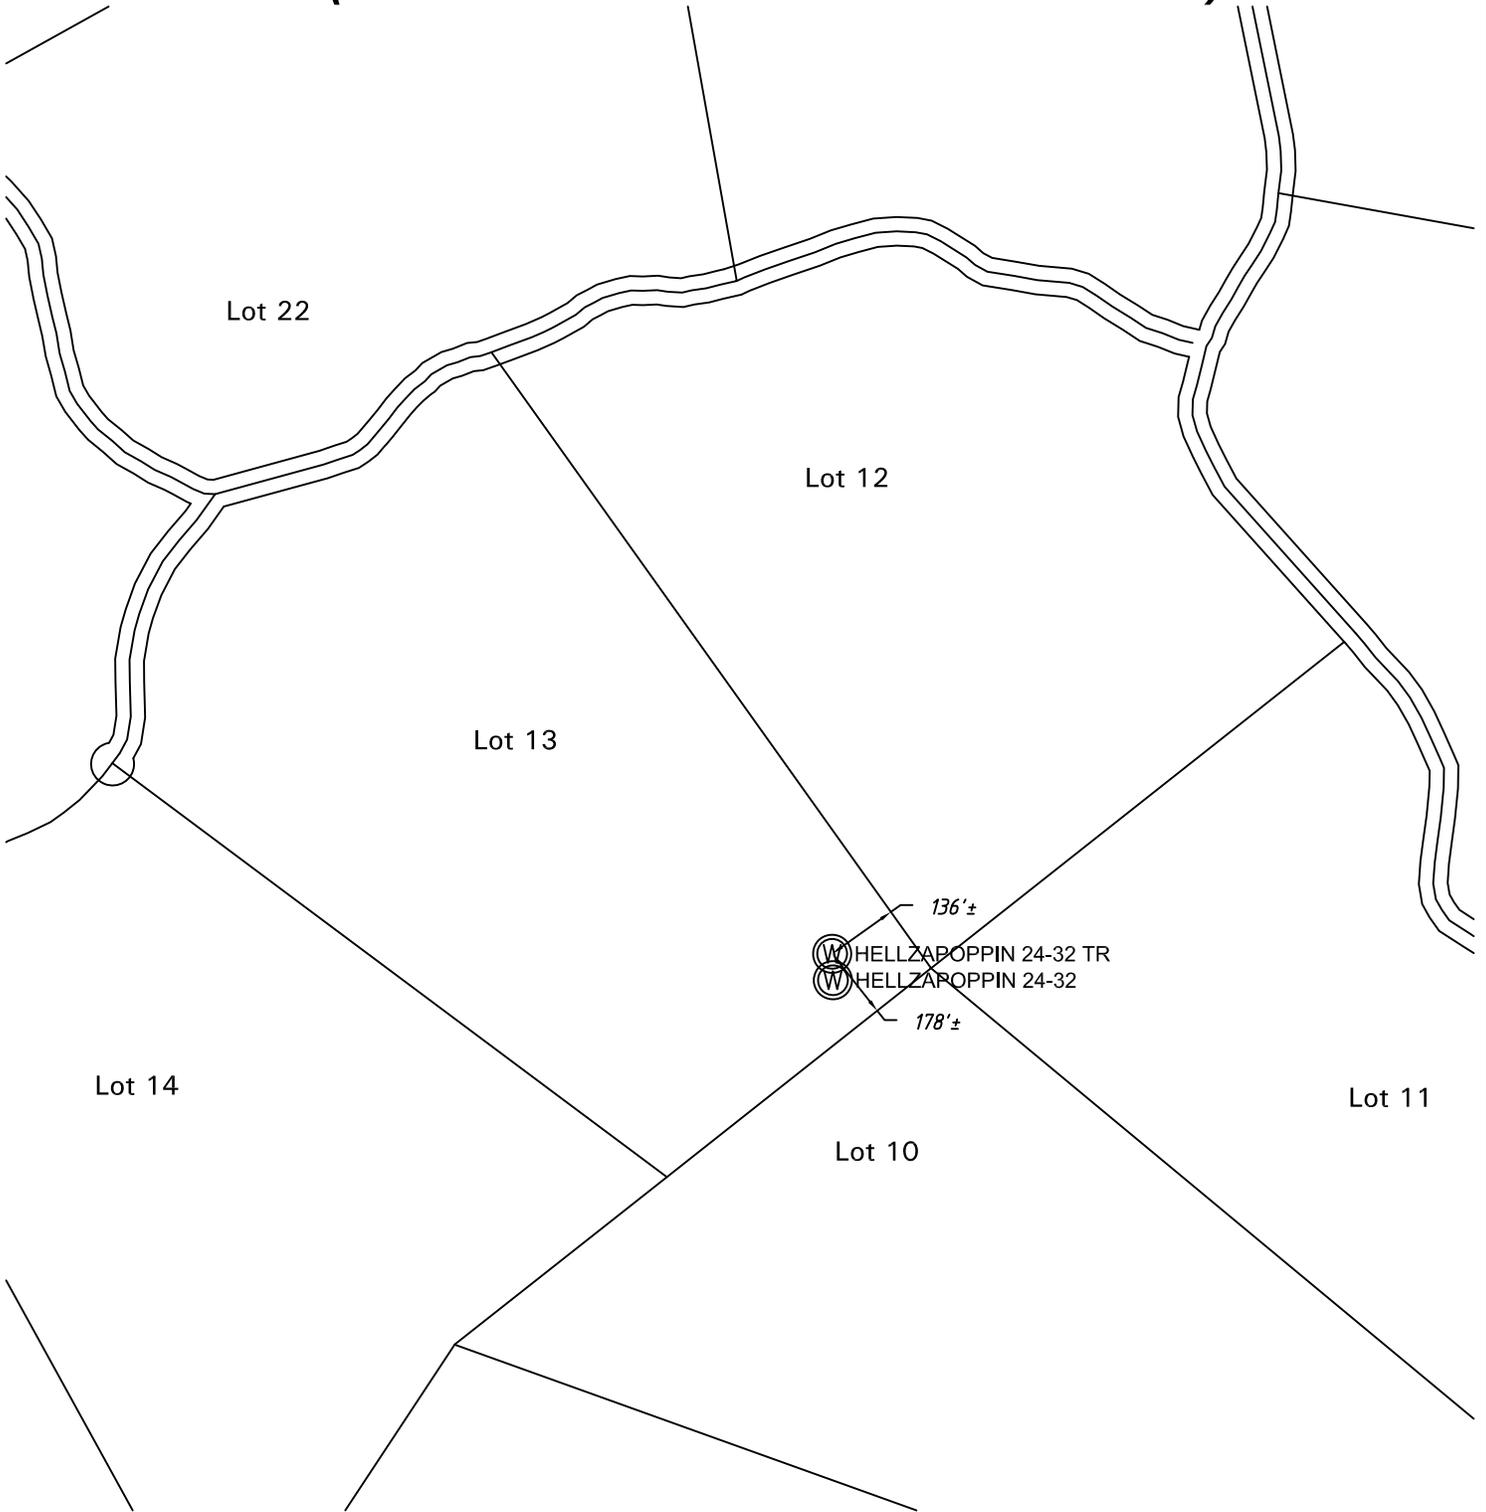

**NOTE:**  
FOOTAGES GIVEN ARE ONLY ESTIMATES BASED ON SUBDIVISION PLATS AND TIED TO EXISTING CONTROL. A FULL BOUNDARY SURVEY IS REQUIRED TO DETERMINE TRUE SUBDIVISION LOT AND ROAD LOCATIONS, DISTANCES AND AREA OR FOOTAGE CALCULATIONS.

DATE: November 19, 2009

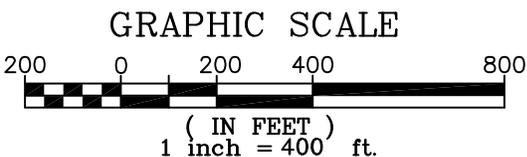

**SHIELDS SURVEY Ltd. Co.**  
Raton, New Mexico 87740  
(575)445-1232