


Location

Heyden 11-22 TR

FROM PROPOSED WELL TO EXISTING WELL: *N50°W, 70'±*

FROM EXISTING WELL TO GAS DRIVE SYSTEM: *S80°W, 30'±*

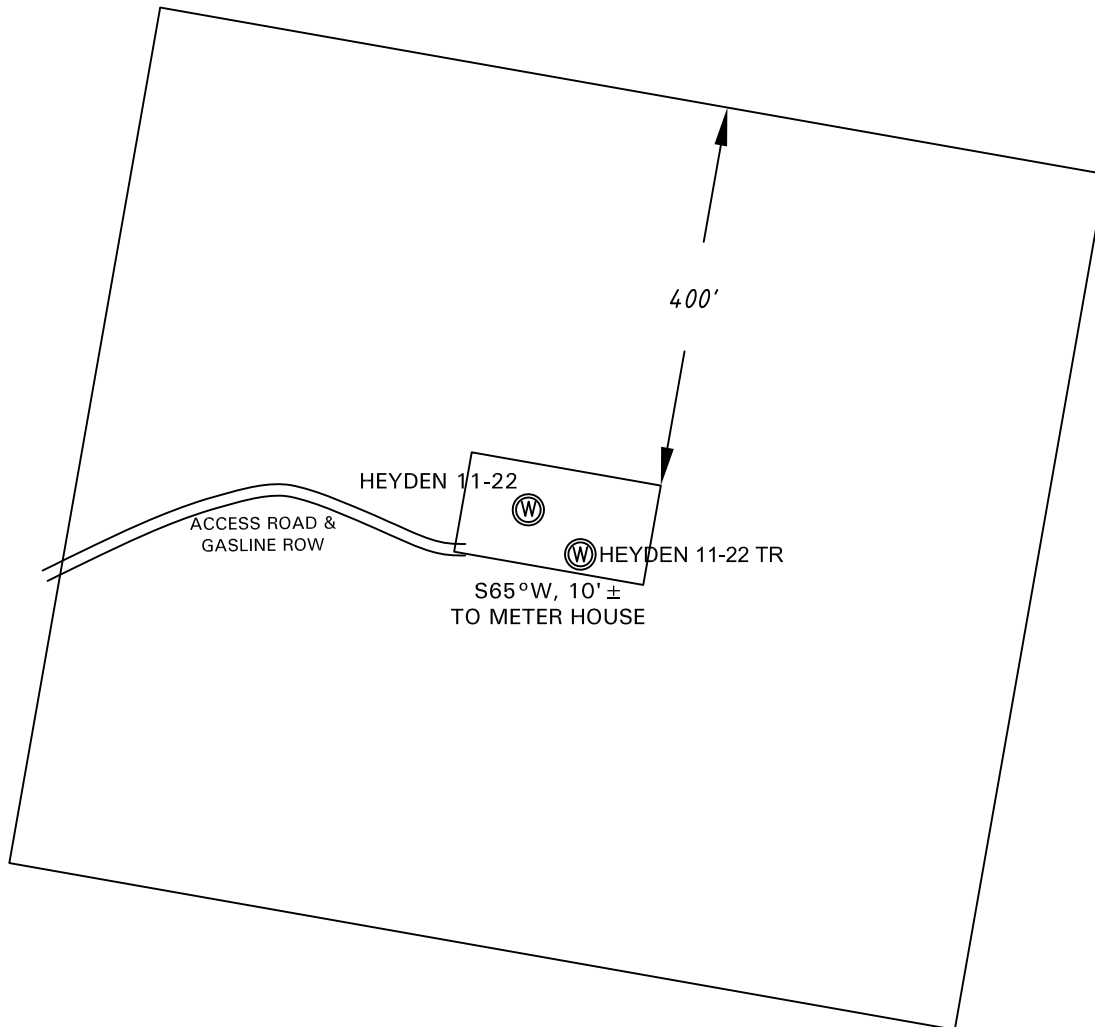


SURFACE USE: *TIMBER*

NOTE:

FOOTAGES GIVEN ARE ONLY ESTIMATES BASED ON SUBDIVISION PLATS AND TIED TO EXISTING CONTROL. A FULL BOUNDARY SURVEY IS REQUIRED TO DETERMINE TRUE SUBDIVISION LOT AND ROAD LOCATIONS, DISTANCES AND AREA OR FOOTAGE CALCULATIONS.

DATE: November 11, 2009

GRAPHIC SCALE

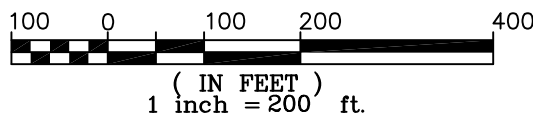

SHIELDS SURVEY Ltd. Co.
Raton, New Mexico 87740
(575)445-1232