


# Location

## **Harvard 42-30 TR**

FROM PROPOSED WELL TO EXISTING WELL: **S25°E, 80' ±**

FROM EXISTING WELL TO GAS DRIVE SYSTEM: **S50°E, 20' ±**

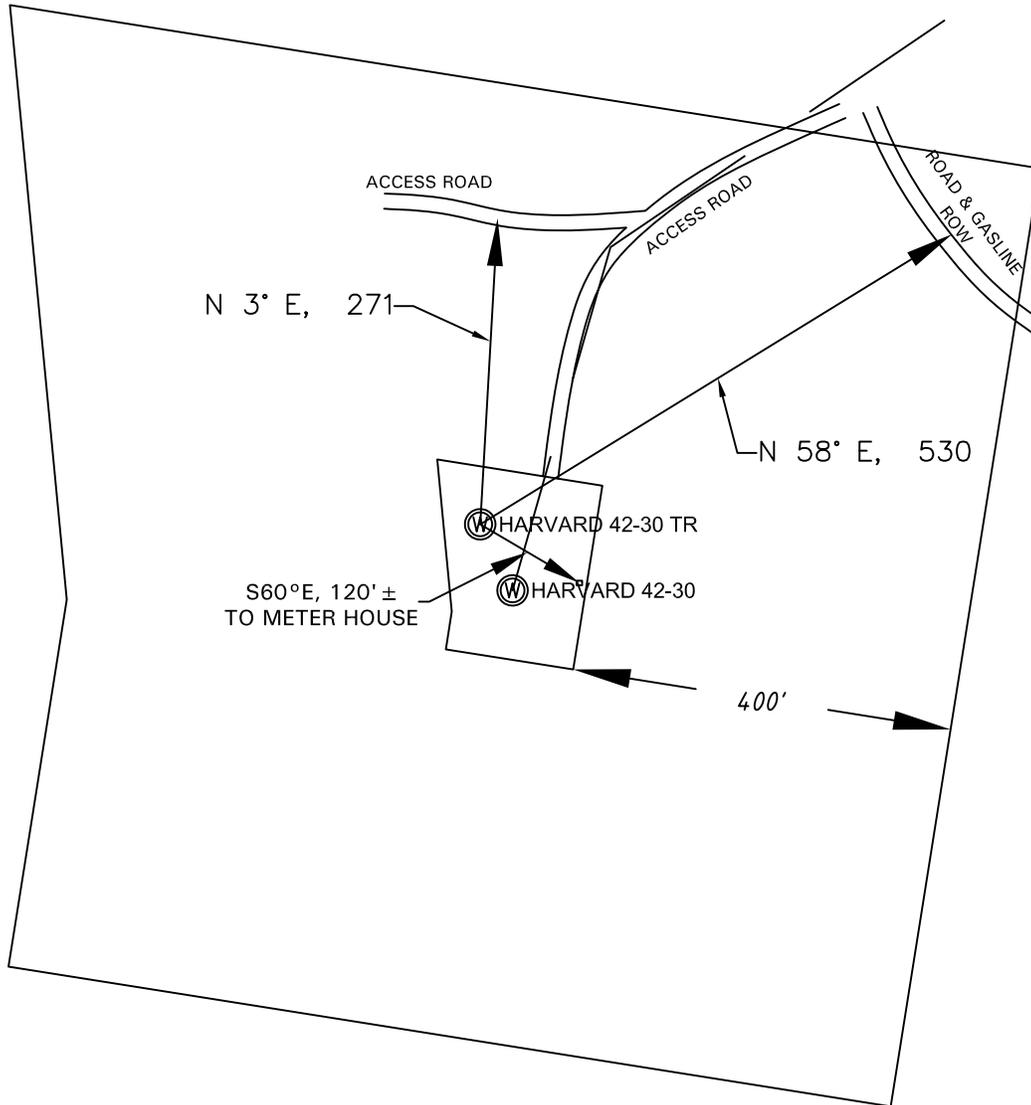


SURFACE USE: **TIMBER**

**NOTE:**

FOOTAGES GIVEN ARE ONLY ESTIMATES BASED ON SUBDIVISION PLATS AND TIED TO EXISTING CONTROL. A FULL BOUNDARY SURVEY IS REQUIRED TO DETERMINE TRUE SUBDIVISION LOT AND ROAD LOCATIONS, DISTANCES AND AREA OR FOOTAGE CALCULATIONS.

DATE: November 10, 2009

### GRAPHIC SCALE

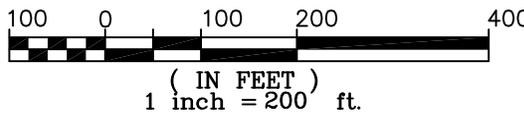

**SHIELDS SURVEY Ltd. Co.**  
Raton, New Mexico 87740  
(575)445-1232