

SCALE 1" = 1000'

T. 8 S.

SHL LATITUDE (NAD 83)

NORTH 39.381680 DEG.

SHL LONGITUDE (NAD 83)

WEST 108.026237 DEG.

SHL NORTHING (NAD 27)

573827.15

SHL EASTING (NAD 27)

1286188.37

BASIS OF DATUM

SPCS CO CENTRAL NAD 27,
BASED ON NGS TRIG. STATION
"FABER"

BASIS OF BEARING

THE BASIS OF BEARINGS FOR
THIS SURVEY IS REFERENCED
TO THE WEST LINE OF THE NW¼
OF SECTION 8, BEING
MONUMENTED AS SHOWN AND
BEARING N 1° 37' 46" E.

NOTES


1. GPS OPERATOR JOHN RICHARDSON OBSERVED A PDOP OF 3.9.
2. ALL GPS OBSERVATIONS ARE IN COMPLIANCE WITH COGCC RULE No. 215.
3. EXISTING IMPROVEMENTS WITHIN 400' OF LOCATION. SEE EXHIBIT 2D.
4. SURROUNDING SURFACE USE IS NATIVE WOODS, NON CROP & RANGELAND.

SURVEYOR'S STATEMENT

I, RICHARD A. BULLEN JR., AN EMPLOYEE AND AGENT ON BEHALF OF D.R. GRIFFIN & ASSOCIATES, INC. STATE THE PLAT HEREON IS A CORRECT REPRESENTATION OF A SURVEY MADE UNDER MY SUPERVISION ON DECEMBER 15, 2008 OF THE SHOWN SGV FEDERAL 8-12A AS STAKED ON THE GROUND AS SHOWN ON THE PLAT.

LEGEND

- ◆ WELL LOCATION
- BOTTOM HOLE LOC. (APPROX)
- FOUND MONUMENT
- ▲ PREVIOUSLY FOUND MONUMENT
- ◎ SET MONUMENT
- L DENOTES 90° TIE

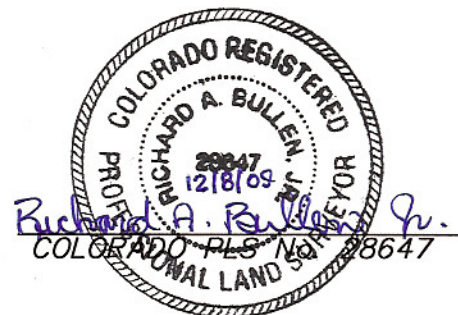

DRG RIFFIN & ASSOCIATES, INC.
(307) 362-5028 1414 ELK ST., ROCK SPRINGS, WY 82901

DRAWN: 3/06/09 - WWG

SCALE: 1" = 1000'

REVISED: 12/4/09 - RCR

DRG JOB No. 13846

Add Q/Q of Section & Dimensions

EXHIBIT 1

**PLAT OF DRILLING LOCATION
FOR NOBLE ENERGY, INC.
SHL IN NW1/4 OF NW1/4 OF SECTION 8**

**1235' F/NL & 325' F/WL, SECTION 8,
T. 8 S., R. 95 W., 6th P.M.
GARFIELD COUNTY, COLORADO**