


1930
GLO BC
W.C.

R. 95 W.

N

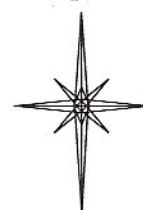

SCALE 1" = 1000'

T. 8 S.

SHL LATITUDE (NAD 83)

NORTH 39.381744 DEG.

SHL LONGITUDE (NAD 83)

WEST 108.026127 DEG.

SHL NORTHING (NAD 27)

573849.23

SHL EASTING (NAD 27)

1286220.14

BASIS OF DATUM

SPCS CO CENTRAL NAD 27,
BASED ON NGS TRIG. STATION
"FABER"

BASIS OF BEARING

THE BASIS OF BEARINGS FOR
THIS SURVEY IS REFERENCED
TO THE WEST LINE OF THE NW $\frac{1}{4}$
OF SECTION 8, BEING
MONUMENTED AS SHOWN AND
BEARING N 1° 37' 46" E.

NOTES

1. GPS OPERATOR JOHN
RICHARDSON
OBSERVED A PDOP OF 3.9.
2. ALL GPS OBSERVATIONS ARE IN
COMPLIANCE WITH COGCC RULE
No. 215.
3. EXISTING IMPROVEMENTS WITHIN
400' OF LOCATION. SEE EXHIBIT 2D.
4. SURROUNDING SURFACE USE IS
NATIVE WOODS, NON CROP &
RANGELAND.

**SGV FEDERAL
8-11C**
**GRADED ELEVATION:
6342.8'**

BASIS OF ELEVATION: NGVD29 USGS
SPOT ELEVATION LOCATED AT THE SE $\frac{1}{4}$,
SECTION 7, T 8 S, R 95 W,
ELEVATION: 6626'

BHL
LATITUDE (NAD 83)
NORTH 39.382840 DEG.
LONGITUDE (NAD 83)
WEST 108.024903 DEG.


1000 500 0 1000 2000
SCALE FEET

SURVEYOR'S STATEMENT

I, RICHARD A. BULLEN JR., AN EMPLOYEE AND AGENT ON BEHALF OF D.R. GRIFFIN & ASSOCIATES, INC. STATE THE PLAT HEREON IS A CORRECT REPRESENTATION OF A SURVEY MADE UNDER MY SUPERVISION ON DECEMBER 15, 2008 OF THE SHOWN SGV FEDERAL 8-11C AS STAKED ON THE GROUND AS SHOWN ON THE PLAT.

LEGEND

- ◆ WELL LOCATION
- BOTTOM HOLE LOC. (APPROX)
- FOUND MONUMENT
- ▲ PREVIOUSLY FOUND MONUMENT
- ⊙ SET MONUMENT
- L DENOTES 90° TIE

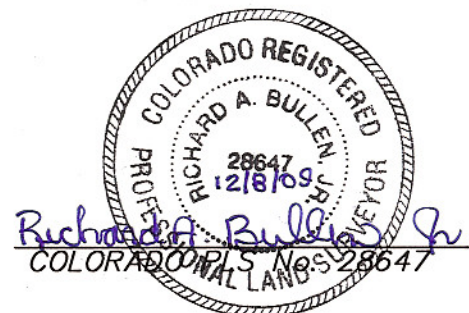

SGV 8D PAD



(307) 362-5028

DRG RIFFIN & ASSOCIATES, INC.

1414 ELK ST., ROCK SPRINGS, WY 82901

DRAWN: 3/06/09 - WWG

SCALE: 1" = 1000'

REVISED: 12/4/09 - RCR

DRG JOB No. 13846

Add Q/Q of Section & Dimensions

EXHIBIT 1

**1213' F/NL & 356' F/WL, SECTION 8,
T. 8 S., R. 95 W., 6th P.M.
GARFIELD COUNTY, COLORADO**