


MULTI-WELL PLAN

KING SURVEYORS, INC. 650 E. GARDEN DR. WINDSOR, CO 80550
SITE SKETCH

SECTION: 28
TOWNSHIP: 5N
RANGE: 66W

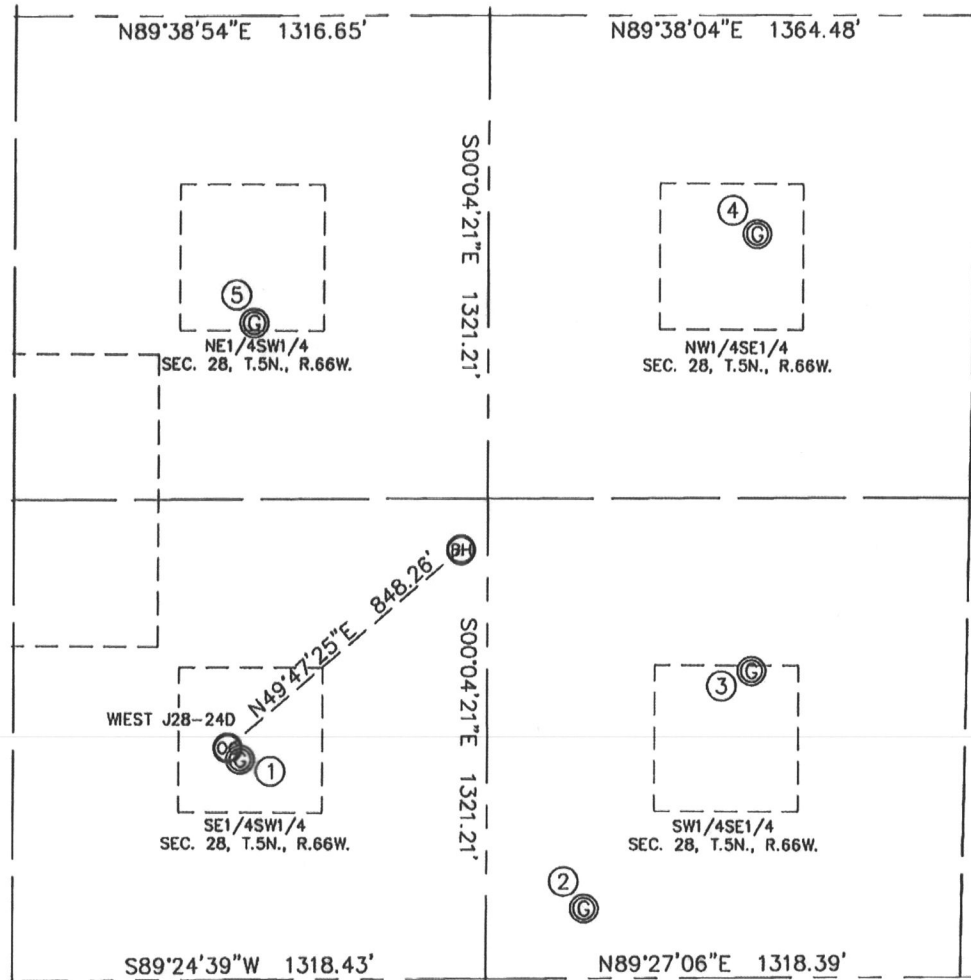

①

ZIONS FNB #1
SE1/4SW1/4
608' FSL
1947' FWL
LAT-40.36493°N
LONG-104.78710°W
PDOP: 1.7
ELEV: 4822

②

MOSSBERG J33-28
SW1/4SE1/4
193' FSL
2369' FEL
LAT-40.36379°N
LONG-104.78366°W
PDOP: 1.1
ELEV: 4802

③

MOSSBERG 28-15H6
SW1/4SE1/4
845' FSL
1930' FEL
LAT-40.36558°N
LONG-104.78199°W
PDOP: 2.1
ELEV: 4799

④

MOSSBERG A 28
NW1/4SE1/4
2042' FSL
1959' FEL
LAT-40.36887°N
LONG-104.78191°W
PDOP: 2.6
ELEV: 4827

⑤

WEST 28-11H6
NE1/4SW1/4
1804' FSL
1981' FWL
LAT-40.36821°N
LONG-104.78695°W
PDOP: 1.1
ELEV: 4837

