


SURVEYOR'S STATEMENT

I, RICHARD A. BULLEN JR., AN EMPLOYEE AND AGENT ON BEHALF OF D.R. GRIFFIN & ASSOCIATES, INC. STATE THE PLAT HEREON IS A CORRECT REPRESENTATION OF A SURVEY MADE UNDER MY SUPERVISION ON DECEMBER 15, 2008 OF THE SHOWN SGV FEDERAL 8-11A AS STAKED ON THE GROUND AS SHOWN ON THE PLAT.

LEGEND

- ◆ WELL LOCATION
- BOTTOM HOLE LOC. (APPROX)
- FOUND MONUMENT
- ▲ PREVIOUSLY FOUND MONUMENT
- ⊙ SET MONUMENT
- L DENOTES 90° TIE

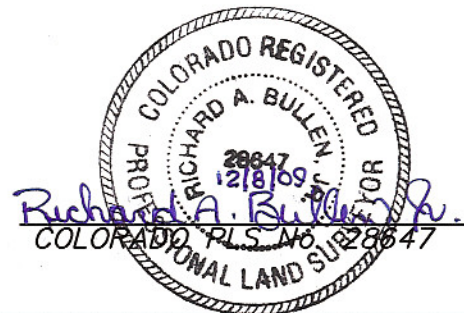

SGV 8D PAD



DRG GRIFFIN & ASSOCIATES, INC.
1414 ELK ST., ROCK SPRINGS, WY 82901

(307) 362-5028

DRAWN: 3/06/09 - WWG

SCALE: 1" = 1000'

REVISED: 12/4/09 - RCR

DRG JOB No. 13846

Add Q/Q of Section & Dimensions

EXHIBIT 1

**PLAT OF DRILLING LOCATION
FOR NOBLE ENERGY, INC.
SHL IN NW1/4 OF NW1/4 OF SECTION 8**

**1233' F/NL & 332' F/WL, SECTION 8,
T. 8 S., R. 95 W., 6th P.M.
GARFIELD COUNTY, COLORADO**