


# WELL LOCATION CERTIFICATE

SECTION 29, TOWNSHIP 4 NORTH, RANGE 67 WEST, 6TH P.M.

**NOTES:**  
 THIS IS A DIRECTIONAL DRILL WELL.  
 BOTTOM HOLE AT 1319' FSL, 2478' FEL.  
 WELL FALLS IN A PLOWED FIELD.  
 A PROPOSED WELL IS 22' SSE.  
 (SEE LOCATION DRAWING FOR IMPROVEMENTS)


GROUND ELEVATION = 4970'  
 LAT. & LONG. = N 40.28350°  
 W 104.91347°

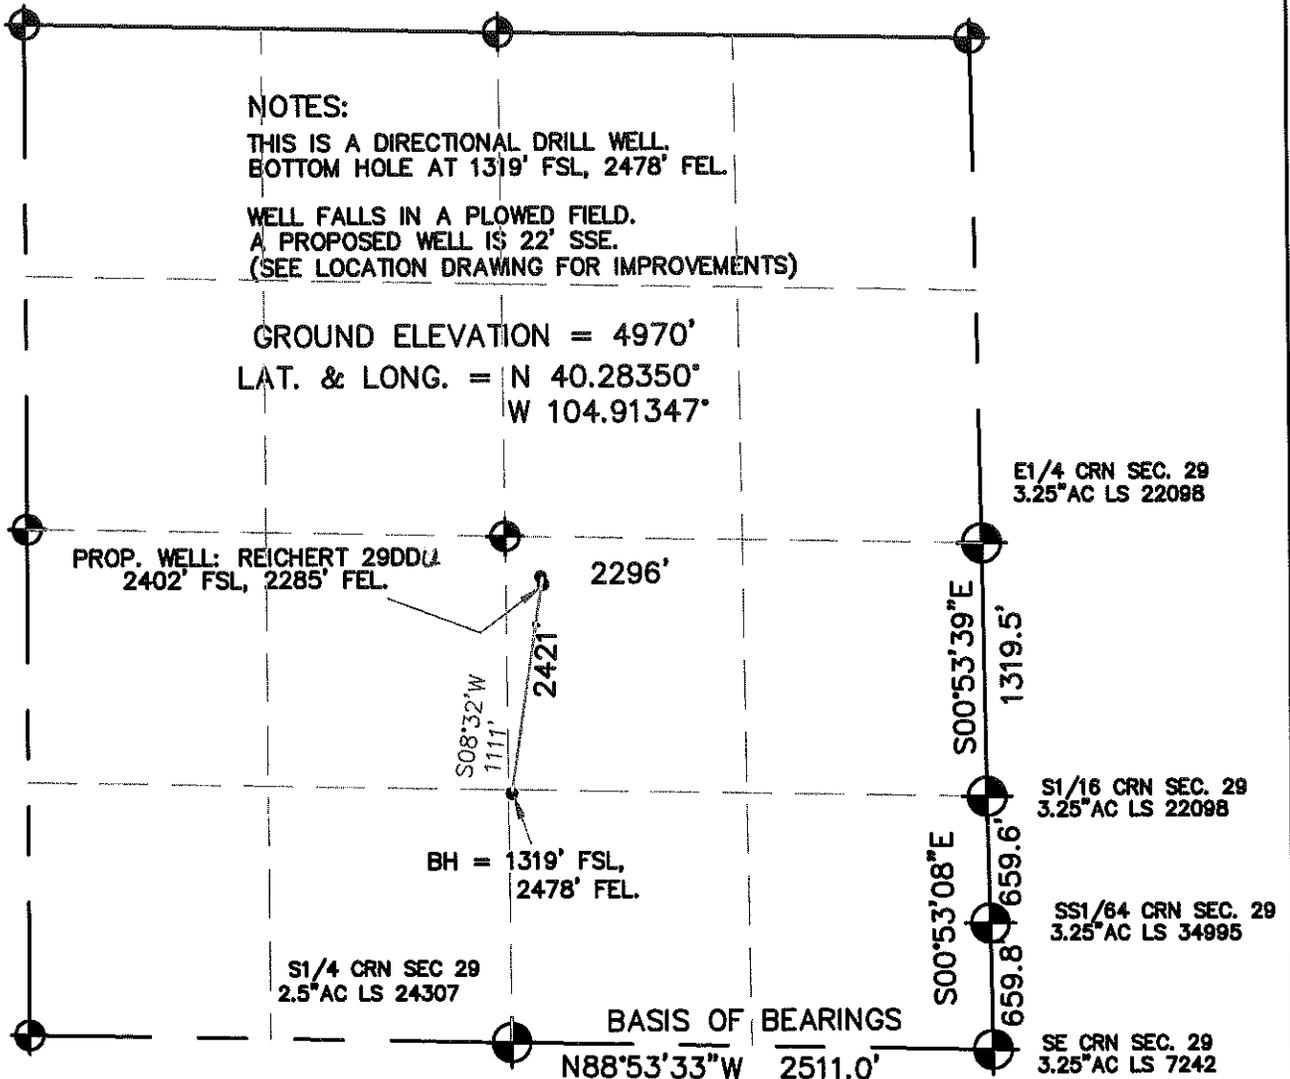

I HEREBY STATE TO UNIOIL THAT THIS WELL LOCATION CERTIFICATE FOR THE WELL REICHERT 29PDU IS LOCATED 2421' FSL & 2296' FEL, SEC. 29, T4N, R67W, 6PM.

**LEGEND**

- = FOUND MONUMENT
- = PROPOSED WELL
- = IMPROVEMENTS (AS LABELED)

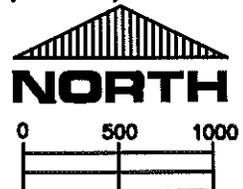

SCALE 1" = 1000'

ELEVATION SOURCE = USGS 7.5' QUAD.MAP CONTOURS  
 NGVD 1929 DATUM.

LAT. & LONG. ARE DIFFERENTIALLY CORRECTED (NAD'83)  
 USING (DGPS) WITH (PDOP) VALUES LESS THAN SIX (6).

SHOWN DISTANCES ARE FIELD MEASURED - EXTERIOR SECTION LINES  
 ARE DRAWN TO SCALE (BEST APPROX. OR FOUND MONUMENT).

THOMAS G. CARLSON, PLS 24657  
 HORSESHOE SURVEYING, LLC

THIS IS NOT A MONUMENTED BOUNDARY SURVEY, IT IS ONLY A  
 DRAWING INTENDED TO DEPICT THE WELL LOCATION TO SECTION LINES.

DISTANCES TO WELL SHOWN PERPENDICULAR  
 TO SECTION LINES.

<b>PREPARED BY:</b>	HORSESHOE SURVEYING, LLC PO BOX 150458 LAKEWOOD, CO 80215 (720)872-0196	<b>WELL NAME:</b>	REICHERT 29PDU
<b>DRAWING DATE:</b> 7-21-09		<b>LOCATION:</b>	WELD COUNTY, CO SE1/4, SEC. 29, T4N, R67W, 6TH P.M.
<b>FIELD DATE:</b> 5-5-09	<b>BY:</b> TGC	<b>CHKD:</b>	<b>JOB NO.</b>  <b>SHEET NO.</b> 1 OF 1

