


LOCATION DRAWING

NE-SW-SW OF SECTION 10, TOWNSHIP 3 SOUTH
RANGE 42 WEST, 6TH P.M.

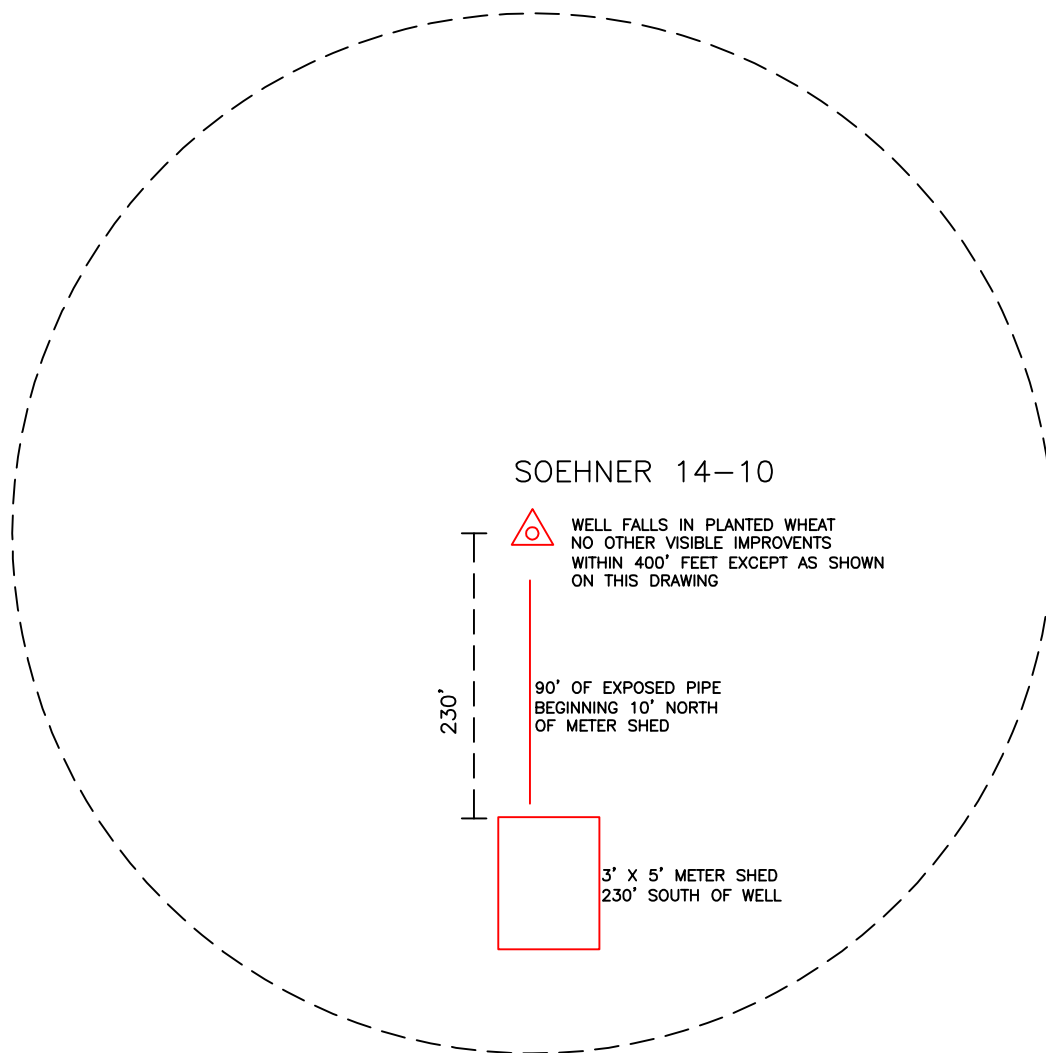

nts

PREPARED BY: DeManche Enterprises	WELL NAME: SOEHNER 14-10
DRAWING DATE: 10/11/09	LOCATION: YUMA COUNTY, COLORADO
FIELD DATE: 10/04/09	NE-SW-SW 1/4 OF SEC 10, T 3 S, R42W, 6TH P.M.