


# Location

## Centerfire 42-22 TR

FROM CENTERFIRE 42-22 TR TO EXISTING WELL:  $N25^{\circ}E, 105' \pm$

FROM EXISTING WELL TO GAS DRIVE SYSTEM:  $S87^{\circ}E, 30' \pm$

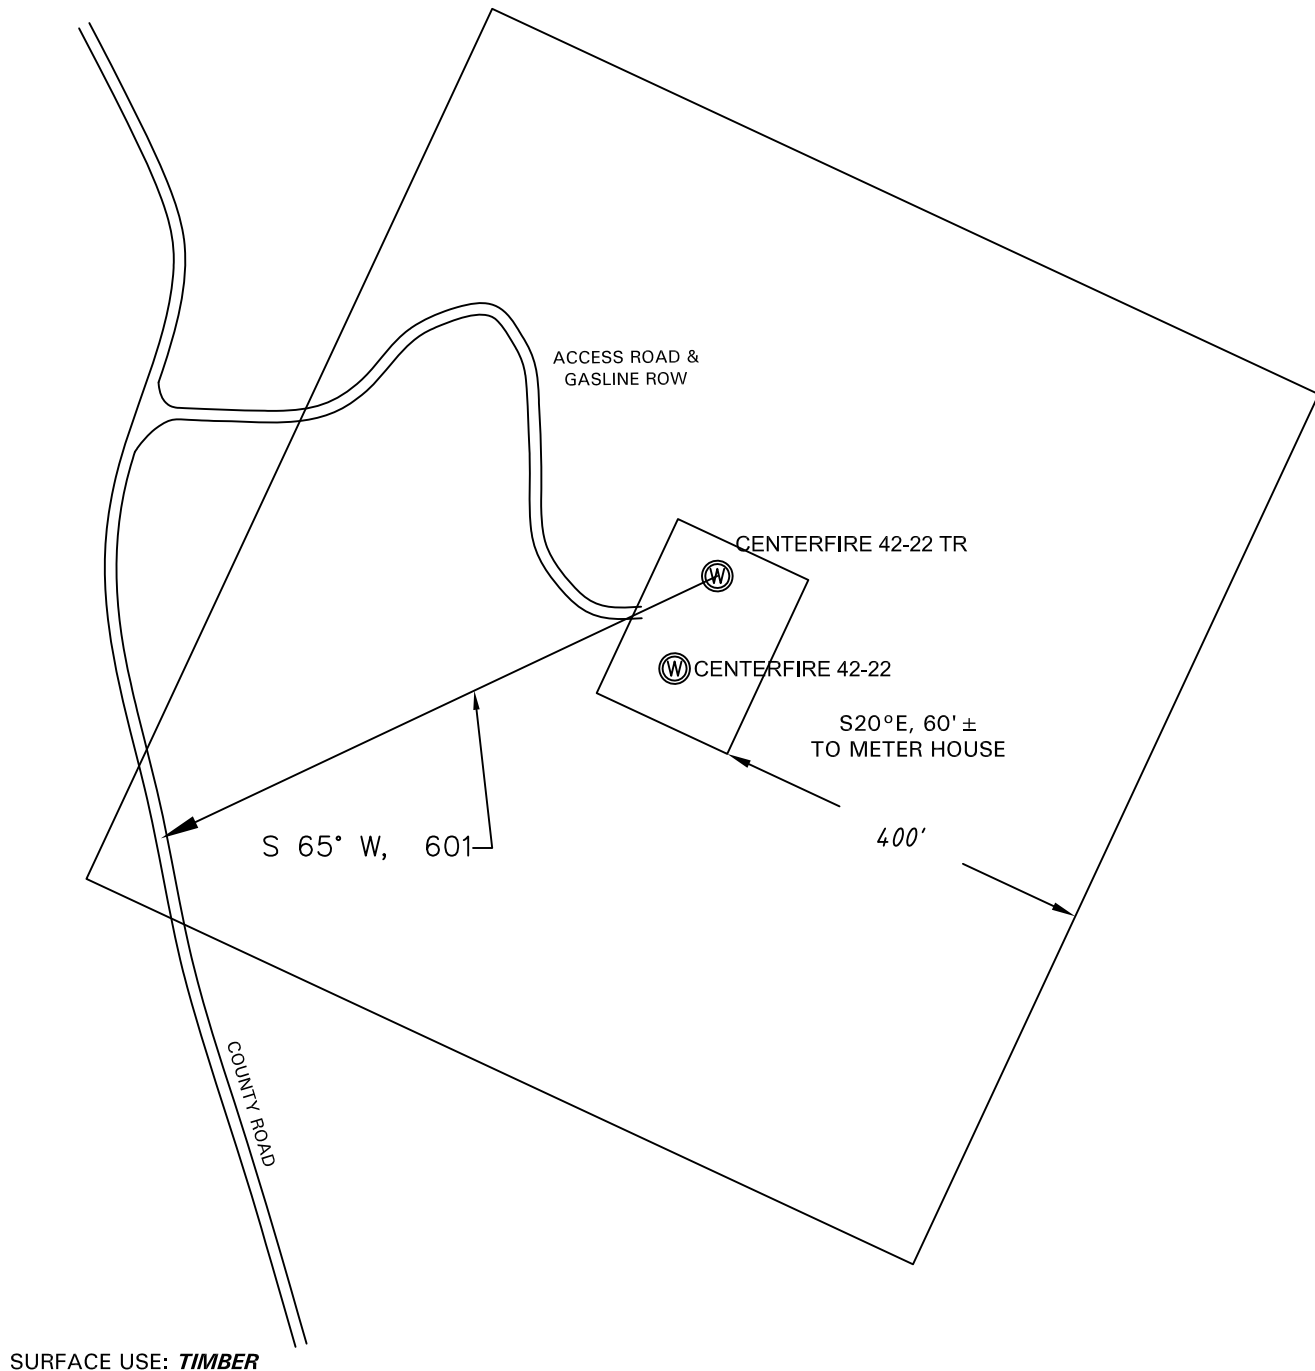


### NOTE:

FOOTAGES GIVEN ARE ONLY ESTIMATES BASED ON SUBDIVISION PLATS AND TIED TO EXISTING CONTROL. A FULL BOUNDARY SURVEY IS REQUIRED TO DETERMINE TRUE SUBDIVISION LOT AND ROAD LOCATIONS, DISTANCES AND AREA OR FOOTAGE CALCULATIONS.

DATE: December 04, 2009

### GRAPHIC SCALE

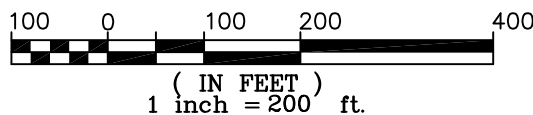

**SHIELDS SURVEY Ltd. Co.**  
Raton, New Mexico 87740  
(575)445-1232