


Location

Boof 12-2 TR

FROM BOOF 12-2 TR TO EXISTING WELL: **S60°W, 45'±**

FROM EXISTING WELL TO GAS DRIVE SYSTEM: **S45°W, 15'±**

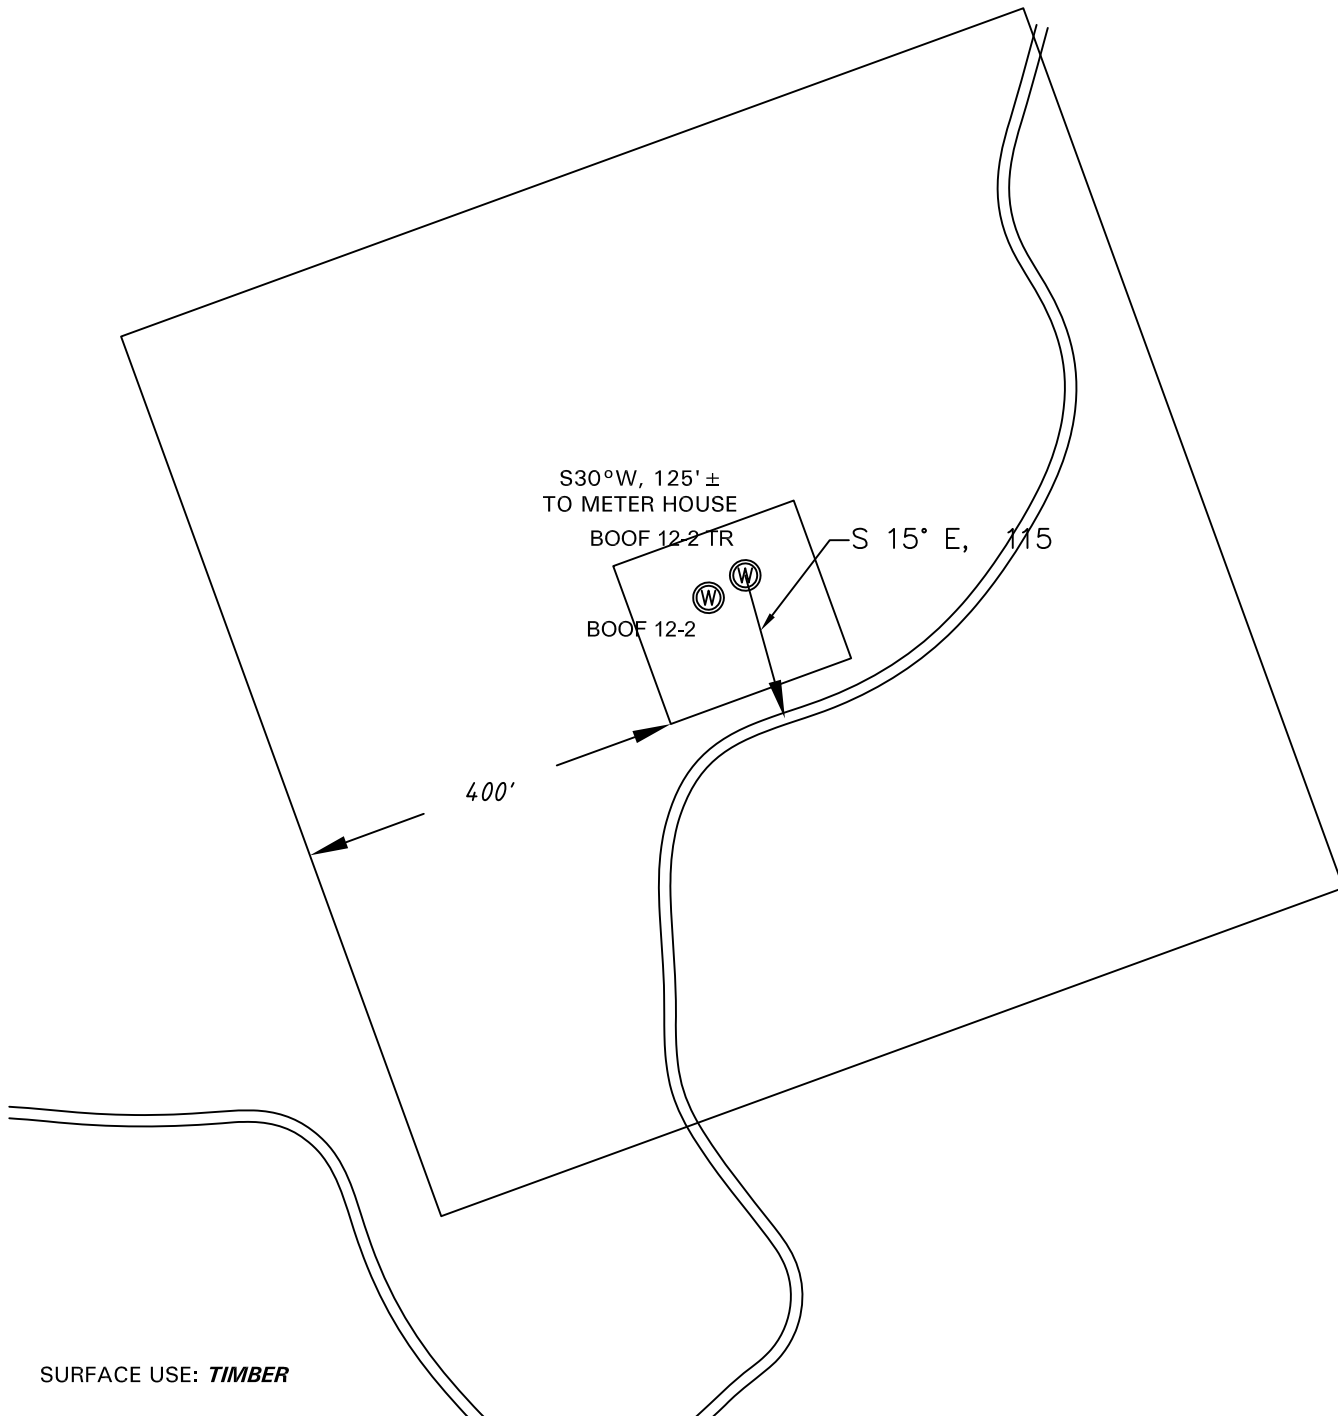


NOTE:

FOOTAGES GIVEN ARE ONLY ESTIMATES BASED ON SUBDIVISION PLATS AND TIED TO EXISTING CONTROL. A FULL BOUNDARY SURVEY IS REQUIRED TO DETERMINE TRUE SUBDIVISION LOT AND ROAD LOCATIONS, DISTANCES AND AREA OR FOOTAGE CALCULATIONS.

DATE: December 04, 2009

GRAPHIC SCALE

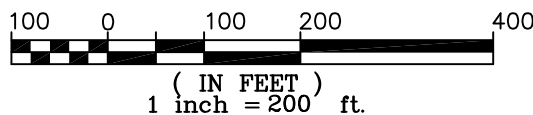

SHIELDS SURVEY Ltd. Co.
Raton, New Mexico 87740
(575)445-1232