



PLAT #1  
LOCATION PLAT

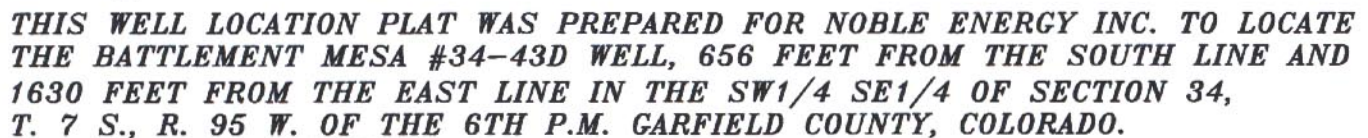

## SURVEYOR'S CERTIFICATE


- I, George R. Bauer: a Professional Land Surveyor in the State of Colorado do hereby certify that this Survey was made under my direct supervision, and that this Plat represents said Survey.

Colorado do hereby certify that this survey was  
direct supervision, and that this Plat represents

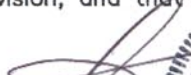  
27925  
rel 4/09

COLORADO P.L.S. 27925

ON SURVEYS, INC.

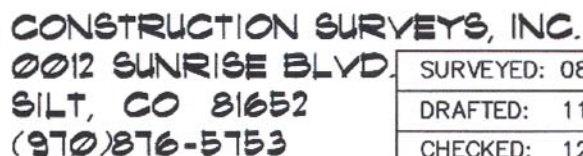

VIEW: 1J

|                    |                          |
|--------------------|--------------------------|
| SURVEYED: 08/28/07 | SCALE: 1" = 1000'        |
| DRAFTED: 11/30/09  | DWG: Noble\2006\Noble340 |
| CHECKED: 12/03/09  | SHEET: 1 of 10           |