


SRC STATE 16P

# IMPROVEMENTS

NE $\frac{1}{4}$ SW $\frac{1}{4}$  SEC. 16, T.4N., R.67W.

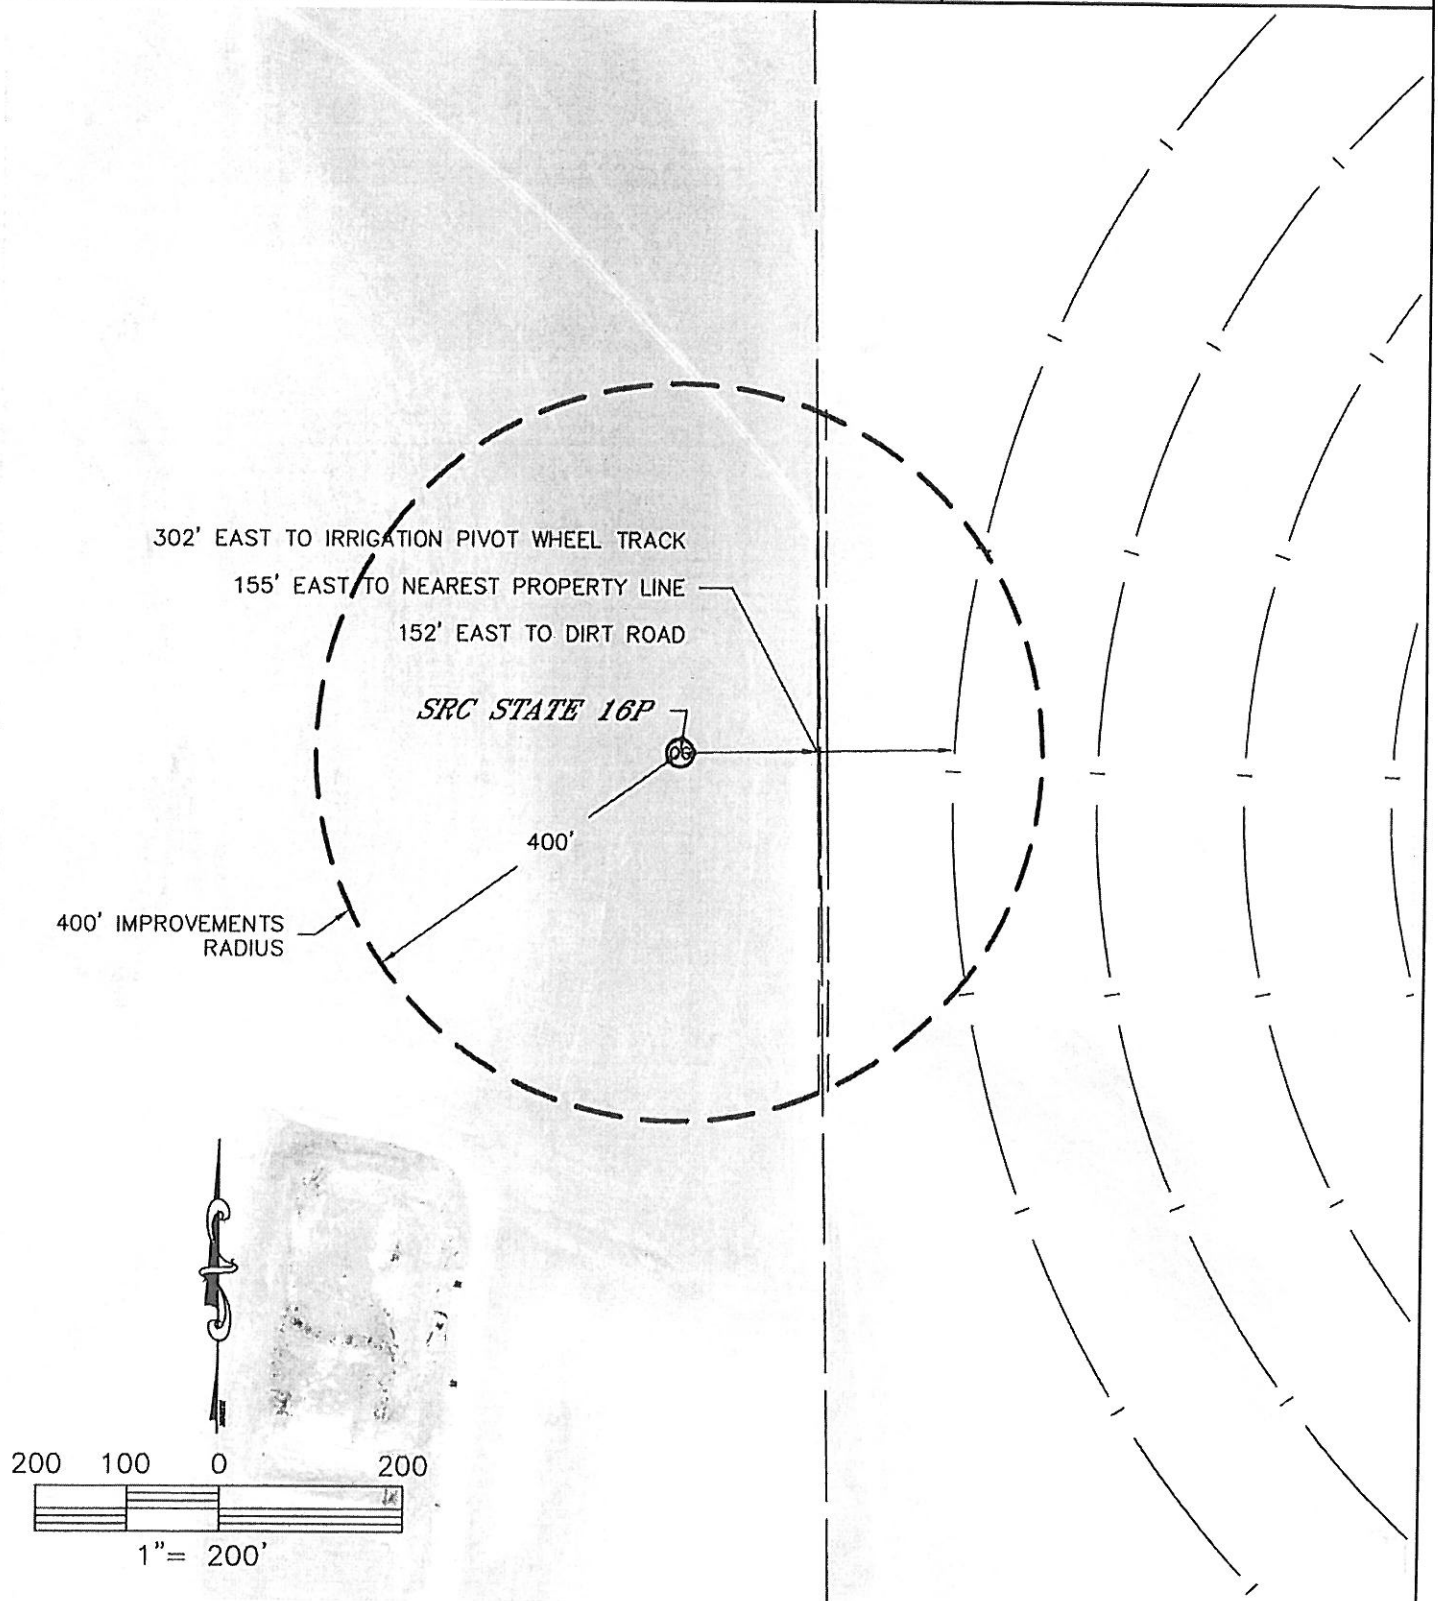

**KING SURVEYORS, INC.**

650 E. Garden Drive | Windsor, Colorado 80550

phone: (970) 686-5011 | fax: (970) 686-5821

[www.kingsurveyors.com](http://www.kingsurveyors.com)

**PROJECT NO: 2008345**

**DATE: 05/20/2009**

**CLIENT: SYNERGY RESOURCES CO.**

**DWG: 2008345WELLS**

**FIELD OPERATOR: DALLAS NIELSEN**

**DATE OF WORK: 05/18/2009**