


WELL LOCATION CERTIFICATE

THIS MAP DOES NOT REPRESENT A BOUNDARY SURVEY

SECTION: 8
TOWNSHIP: 3N
RANGE: 67W

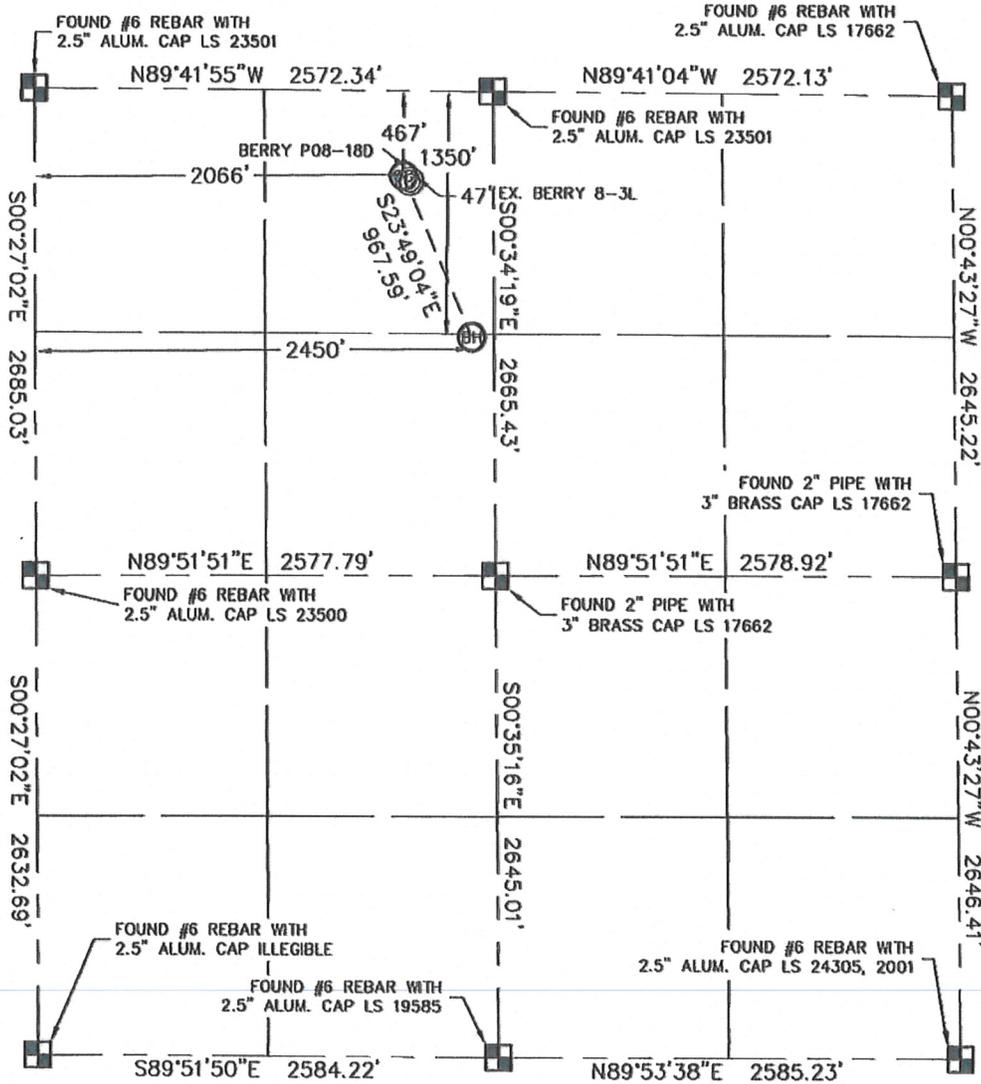

In accordance with a request from Erik VanDecar with Noble Energy Inc. King Surveyors Inc. has determined the surface location of the Berry POB-18D to be 467' from the North line and 2066' from the West line and the bottom hole to be 1350' from the North line and 2450' from the West line as measured at right angles from the section line of Section 8, Township 3 North, Range 67 West of the Sixth Principal Meridian, County of Weld, State of Colorado.

I hereby state that this Well Location Certificate was prepared by me, or under my direct supervision, that the fieldwork was completed on 7-29-09, for and on behalf of Noble Energy Inc. That this is not a Land Survey Plot or an Improvement Survey Plot, and that it is not to be relied upon for establishment of fence, building, or other future improvement lines.

NOTE:

- 1) Bearings shown are Grid Bearings of the Colorado State Plane Coordinate System, North Zone, North American Datum 1983/2007. The lined dimensions as contained herein are based upon the "U.S. Survey Foot."
- 2) Ground elevations are based on an observed GPS elevation (NAVD 1988 DATUM).
- 3) NEAREST EXISTING WELL: BERRY 8-3L 47'
- 4) IMPROVEMENTS: See VISIBLE IMPROVEMENTS exhibit for all visible improvements within 400' of well head.
- 5) SURFACE USE: PASTURE, EX. WELL SITE

SURFACE LOCATION

LATITUDE: 40.24642°N
LONGITUDE: 104.91587°W
PDOP: 1.7
ELEV: 4818
1/4,1/4: NE1/4NW1/4
NEAREST PROPERTY LINE: 467' NORTH

BOTTOM HOLE

LATITUDE: 40.24398°N
LONGITUDE: 104.91449°W

NOTE

According to Colorado law, you must commence any legal action based upon any defect in this W.L.C. within three years after you discover such defect. In no event, may any action based upon any defect in this survey be commenced more than ten years after the date of the certificate shown hereon. (13-80-105 C.R.S.)

LEGEND

-  = ALIQUOT MONUMENT AS DESCRIBED
-  = CALCULATED POSITION


Steven A. Lund, On behalf of King Surveyors, Inc.
Licensed Land Surveyor No. 34995
State of Colorado

2009

PROJECT#: 2009245

KING SURVEYORS, INC. 650 E. GARDEN DR. WINDSOR, CO 80550
SITE SKETCH

SECTION: 8
 TOWNSHIP: 3N
 RANGE: 67W

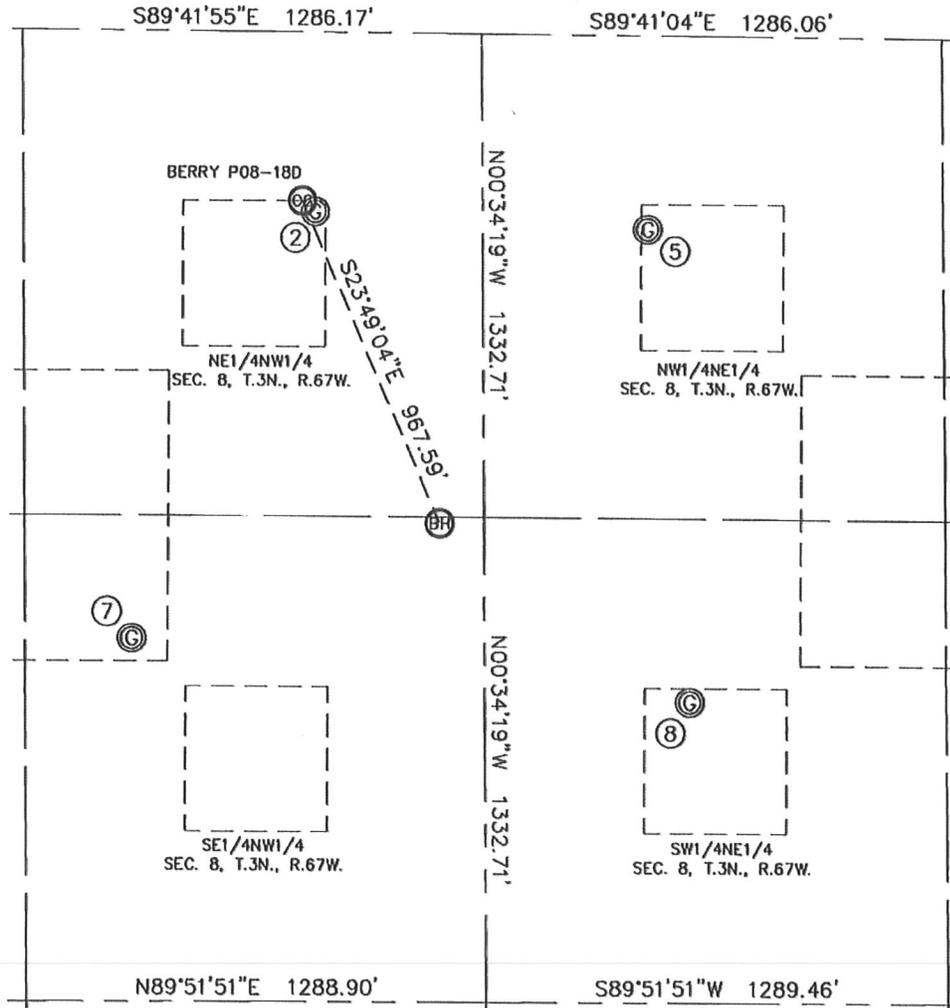

②
 BERRY 8-3L
 NE1/4NW1/4
 496' FNL
 2103' FWL
 LAT-40.24633°N
 LONG-104.91574°W
 PDOP: 2.4
 ELEV: 4818

⑤
 HSR-BERRY 2-8
 NW1/4NE1/4
 535' FNL
 2111' FEL
 LAT-40.24620°N
 LONG-104.91240°W
 PDOP: 1.9
 ELEV: 4830

⑦
 BERRY 8-6L
 SE1/4NW1/4
 1673' FNL
 1585' FWL
 LAT-40.24312°N
 LONG-104.91759°W
 PDOP: 1.4
 ELEV: 4833

⑧
 HSR-BERRY 7-8
 SW1/4NE1/4
 1834' FNL
 2003' FEL
 LAT-40.24263°N
 LONG-104.91198°W
 PDOP: 1.9
 ELEV: 4821

