

MULTI WELL PLAN


Steil Surveying Services, LLC

1102 West 19th Street P.O. BOX 2073



Cheyenne, Wyoming 82009

SITE SKETCH

SECTION 15
TOWNSHIP 2 NORTH
RANGE 66 WEST

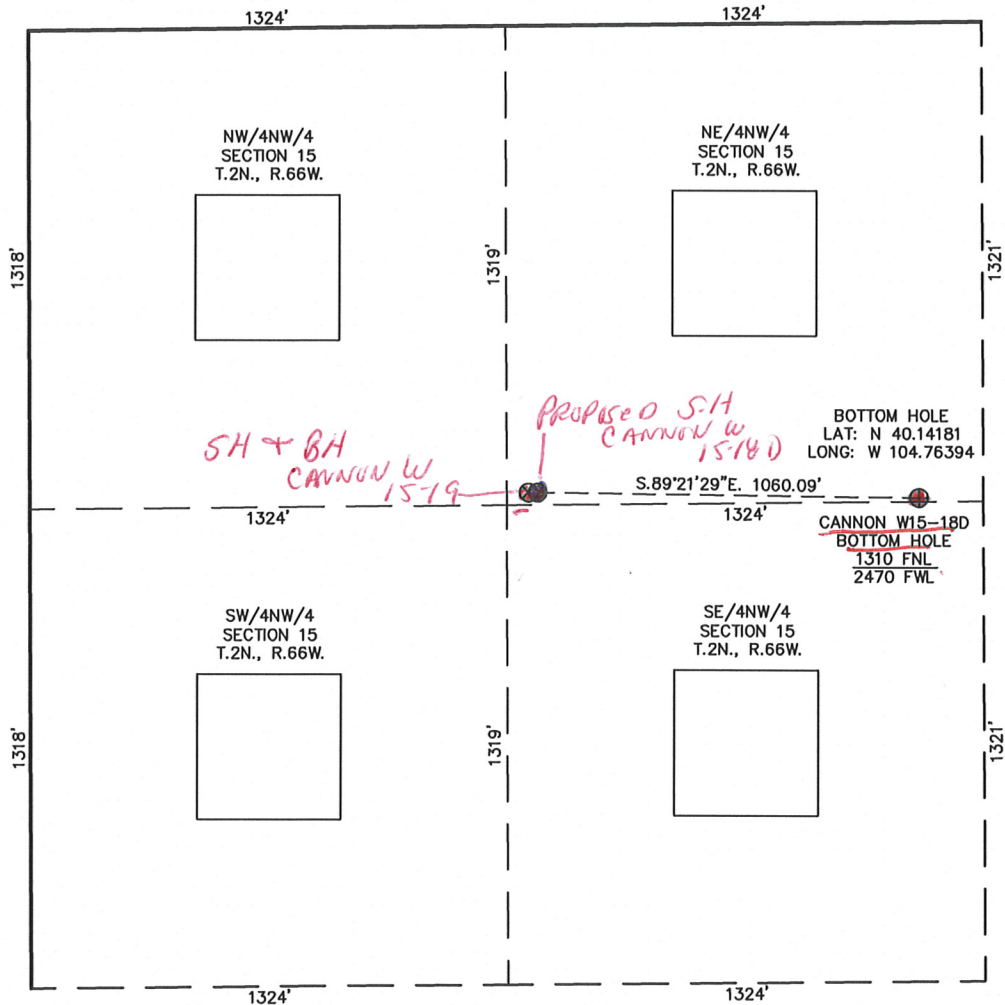

WELL PAD DETAIL

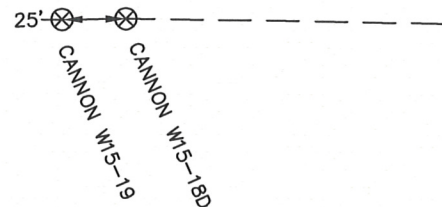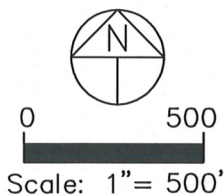

NOTES:

- 1) THIS SKETCH DOES NOT REPRESENT A BOUNDARY SURVEY.
- 2) THE DATUM FOR THE LATITUDES AND LONGITUDES ON THIS SKETCH IS NAD83.