


# LOCATION DRAWING

N1/2-SE-SE OF SECTION 26, TOWNSHIP 1 NORTH  
RANGE 45 WEST, 6TH P.M.

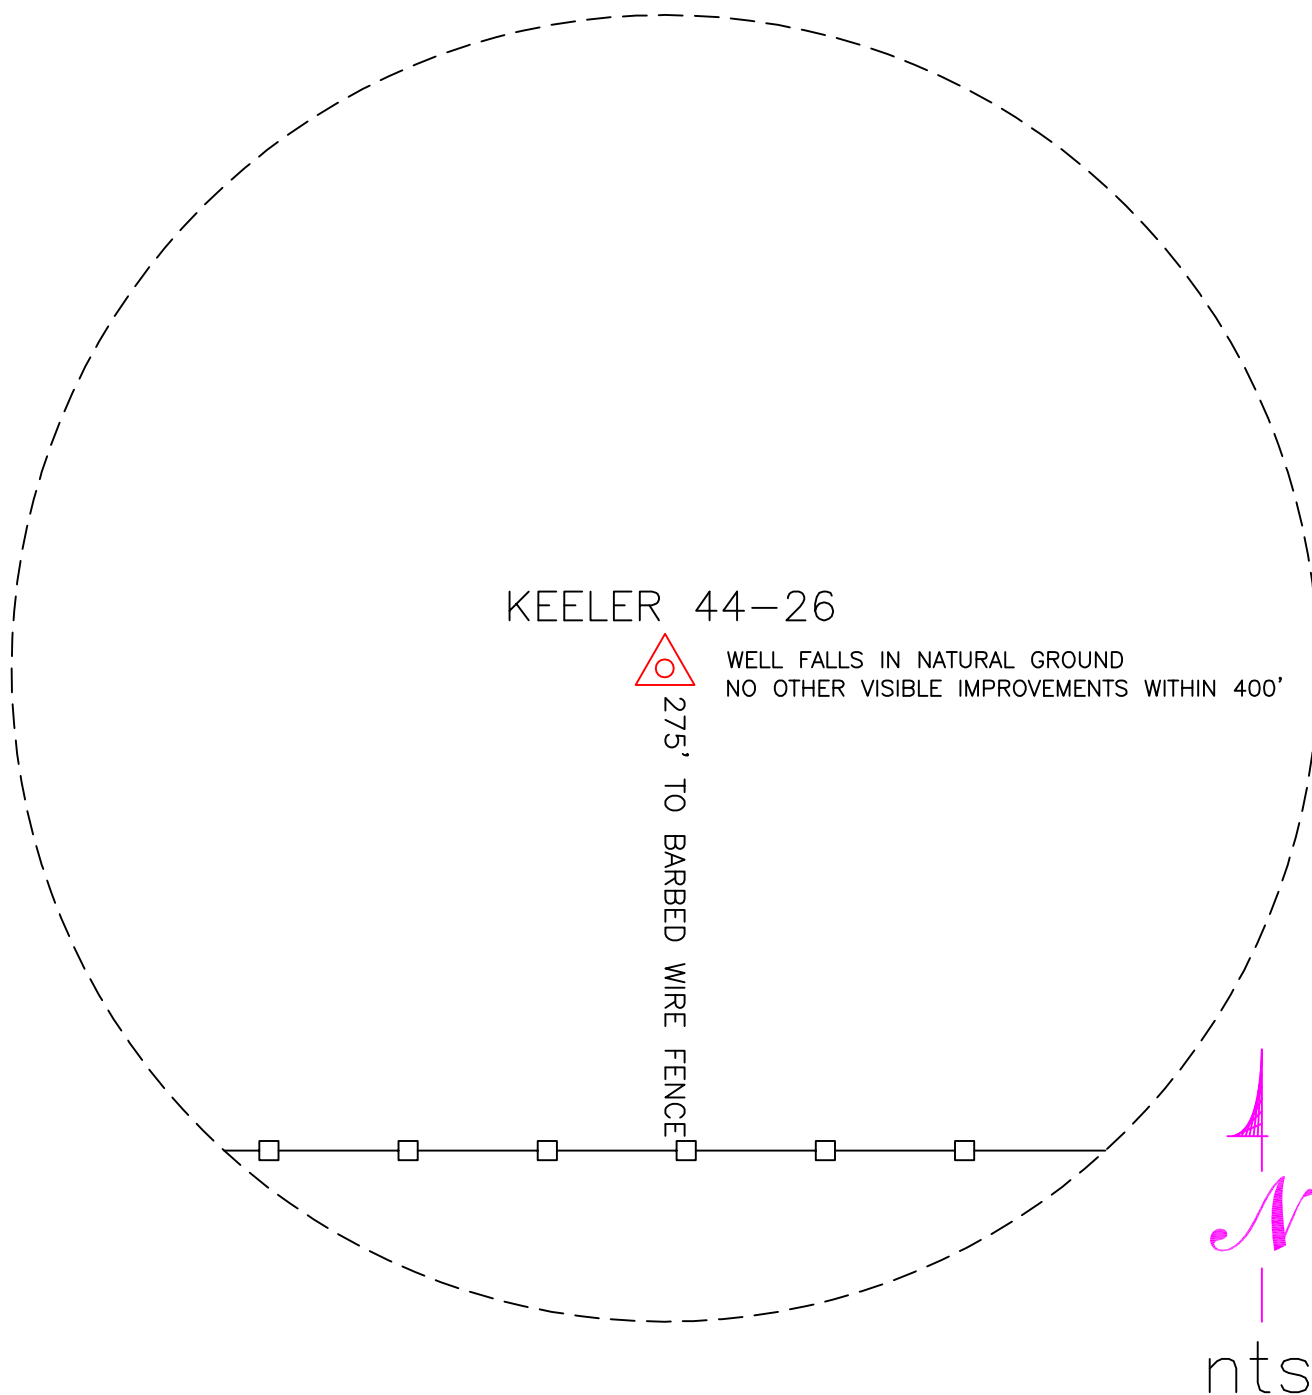

PREPARED BY: DeManche Enterprises	WELL NAME: KEELER 44-26
DRAWING DATE: 10/18/09	LOCATION: YUMA COUNTY, COLORADO
FIELD DATE: 10/16/09	N1/2 SE-SE 1/4 OF SEC 26, T1N, R45W, 6TH P.M.