



Atlas Surveying Company 5082 East Hampden Avenue #325 Denver, Colorado 80222
WELL LOCATION CERTIFICATE
THIS MAP DOES NOT REPRESENT A BOUNDARY SURVEY

RECEIVED

SECTION 20
TOWNSHIP 1 SOUTH
RANGE 34 WEST
NOV 6 2008

PARISET 20-12

YCR 27

FOUND 3-1/4" ALUM
CAP LS 26602

N89°20'39"E 5307 25'

FOUND 3-1/4" ALUM
CAP LS 26602

YCR 'BB'

N01°09'12"W 5312 57'

20

FOUND 3-1/4" ALUM
CAP LS 26602

YCR 'CC'

S01°14'03"E 2651 51'

S01°13'37"E 2651 26'

PARISET
20-12
EL. 3936'

585'
1886'

FOUND 3-1/4" ALUM
CAP LS 26602

S89°14'16"W 5314 33'
YCR 26

FOUND 3-1/4" ALUM
CAP LS 26602



0 1000
Scale 1" = 1000 ft

IN ACCORDANCE WITH A REQUEST FROM JAMES KARO - ROSETTA RESOURCES,
ATLAS SURVEYING COMPANY, INC. HAS DETERMINED THE LOCATION OF THE PARISET 20-12
TO BE 1686' FSL, 565' FWL, AS MEASURED AT NINETY (90) DEGREES FROM THE SECTION LINES,
SECTION 20, TOWNSHIP 1 SOUTH, RANGE 44 WEST, 6TH PRINCIPLE MERIDIAN, YUMA COUNTY, COLORADO.

I HEREBY CERTIFY THAT THIS WELL LOCATION CERTIFICATE WAS PREPARED BY ME, OR UNDER MY DIRECT
SUPERVISION ON 10/07/2008, FOR AND ON BEHALF OF ROSETTA RESOURCES,
THAT IT IS NOT A LAND SURVEY PLAT OR AN IMPROVEMENT SURVEY PLAT, AND THAT IT IS NOT TO BE RELIED
UPON FOR ESTABLISHMENT OF FENCE, BUILDING, OR OTHER FUTURE IMPROVEMENT LINES.

NOTES:


- 1) BASIS OF BEARINGS FOR THIS MAP ARE BASED UPON GPS OBSERVATIONS
MADE ON 07/16/2008 BETWEEN MONUMENTS LOCATED AT THE SOUTHEAST
SECTION CORNER AND THE NORTHEAST SECTION CORNER OF SAID SECTION AND
WITH ALL BEARINGS SHOWN HEREON RELATIVE THERETO.
- 2) ELEVATIONS ARE BASED UPON THE AVERAGE OF SPOT ELEVATIONS DEPICTED
ON THE U.S.G.S. 7.5 MINUTE QUADRANGLE MAP OF THE SECTION SHOWN HEREON
- 3) THERE ARE NO IMPROVEMENTS WITHIN 200 FEET OF THE LOCATION
- 4) THE LOCATION FALLS IN AN AGRICULTURAL FIELD.
- 5) THE NEAREST CENTER PIVOT SPRINKLER TOWER TRACK IS 40' WEST

LATITUDE & LONGITUDE (NAD 83 SURFACE HOLE):
LATITUDE: N 39 05252"
LONGITUDE: W 102.33404
PDOP: 2.03

LEGEND

- (A) - FOUND SURVEY MONUMENT PER
MONUMENT RECORD EXCEPTIONS NOTED.
(C) - CALCULATED DIMENSION

NOTICE: According to Colorado law you MUST
commence any legal action based upon any defect
in this W.L.C. within three years after you
first discover such defect. In no event may
any action based upon any defect in this
W.L.C. be commenced more than ten years from
the date of the certification shown hereon.

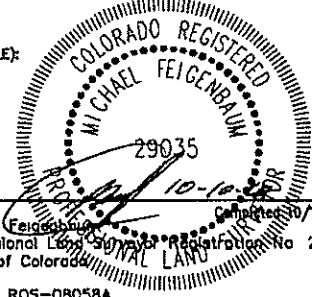

Michael Feigenbaum
Professional Land Surveyor
State of Colorado

JOB # ROS-08058A