MULTI-WELL PLAN

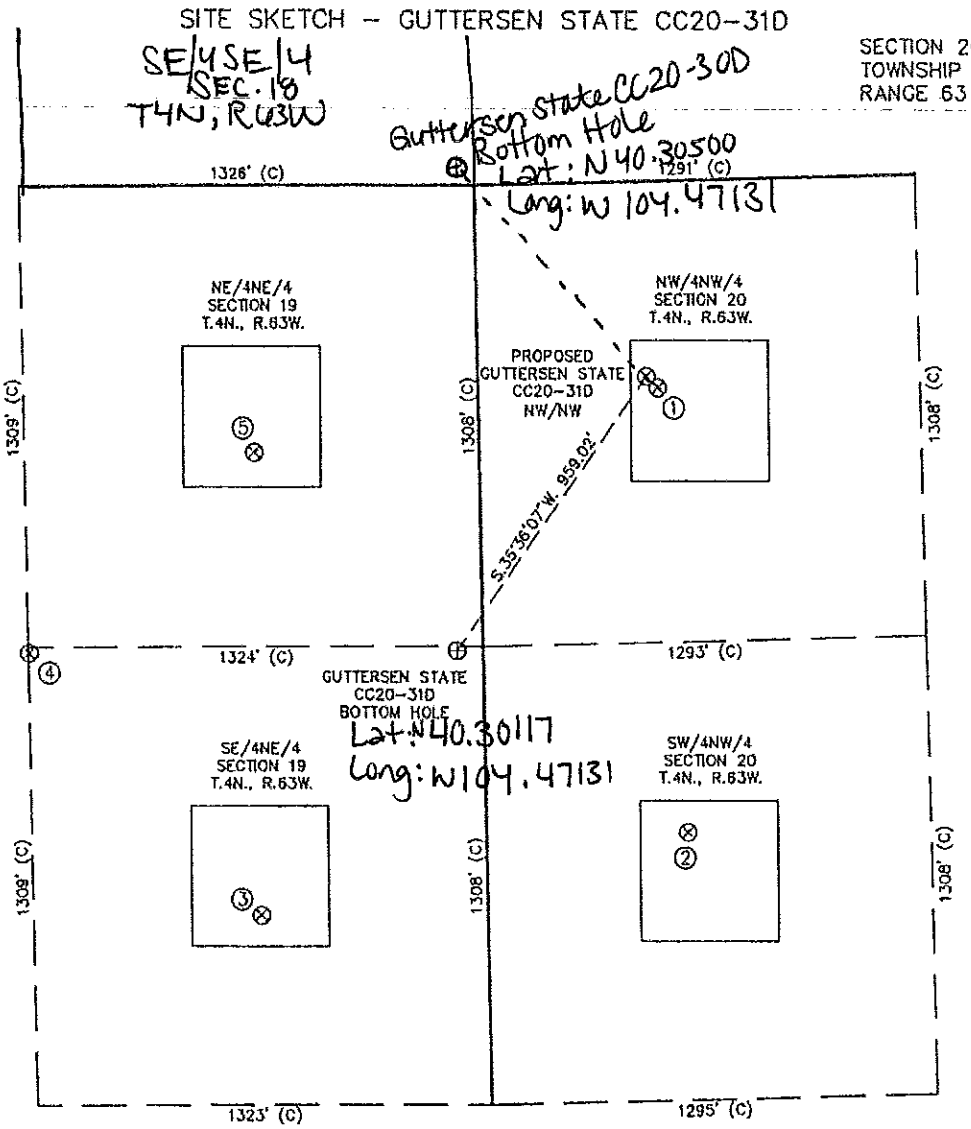

①	②	③	④	⑤
GUTTERSEN	GUTTERSEN	SATER USX	SATER USX	SATER USX
STATE CC20-4JI	STATE CC20-5JI	CC19-8	CC19-17	CC19-1
NW/NW SEC. 20	SW/NW SEC. 20	SE/NE SEC. 19	SE/NE SEC. 19	NE/NE SEC. 19
587' FNL	1852' FNL	2075' FNL	1325' FNL	757' FNL
525' FWL	587' FWL	659' FEL	1322' FEL	656' FEL
EL 4691'	EL 4714'	EL 4706'	EL 4681'	EL 4681'
N 40.30320	N 40.29973	N 40.29911	N 40.30118	N 40.30273
W 104.46916	W 104.46894	W 104.47341	W 104.47578	W 104.47340
PDOP 2.0	PDOP 2.4	PDOP 2.5	PDOP 2.5	PDOP 2.5

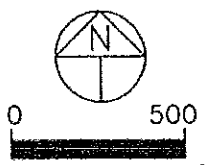

Scale: 1" = 500'

NOTES:
1) THIS SKETCH DOES NOT REPRESENT A BOUNDARY SURVEY.
2) THE DATUM FOR THE LATITUDES AND LONGITUDES ON THIS SKETCH IS NAD83.