

WELL LOCATION CERTIFICATE

NW CRN SEC. 10
2" PIPE IN CONC.

SECTION 10, TOWNSHIP 4 NORTH, RANGE 67 WEST, 6TH P.M.
S88°25'53"E 2648.7' S88°29'31"E 2646.5'

NE CRN SEC. 10
2.5" AC LS 24305

N1/4 CRN SEC. 10
3.25" AC LS 7242

BH = 1269' FNL,
2594' FEL.

BASIS OF BEARINGS

2632.7'

N00°00'25"E

W1/4 CRN SEC. 10
3.25" AC LS 17664

2624'

PROP.: BINDER 10-CDU
2375' FNL, 2624' FWL.

2649.7'

S00°25'58"W

E1/4 CRN SEC. 10
3.25" AC LS 7242


NOTES:

THIS IS A DIRECTIONAL DRILL WELL.
BOTTOM HOLE AT 1269' FNL, 2594' FEL.

A PROPOSED WELL IS 22' S.
SEE LOCATION DRAWING FOR IMPROVEMENTS


GROUND ELEVATION = 4780'
LAT. & LONG. = N 40.32765°
W 104.87719°

I HEREBY STATE TO UNIOIL THAT THIS WELL LOCATION CERTIFICATE
FOR THE WELL BINDER 10-NDU IS LOCATED 2353' FNL & 2624' FWL, SEC. 10, T4N, R67W, 6PM.

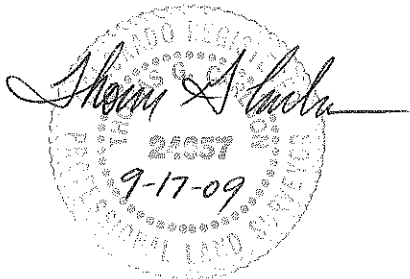

LEGEND

- = FOUND MONUMENT
- = PROPOSED WELL
- = IMPROVEMENTS (AS LABELED)

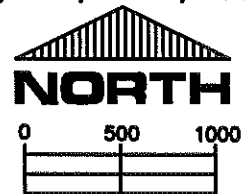

SCALE 1" = 1000'

ELEVATION SOURCE = USGS 7.5' QUAD.MAP CONTOURS
NGVD 1929 DATUM.

LAT. & LONG. ARE DIFFERENTIALLY CORRECTED (NAD'83)
USING (DGPS) WITH (PDOP) VALUES LESS THAN SIX (6).

SHOWN DISTANCES ARE FIELD MEASURED - EXTERIOR SECTION LINES
ARE DRAWN TO SCALE (BEST APPROX. OR FOUND MONUMENT).

THOMAS G. CARLSON, PLS 24657
HORSESHOE SURVEYING, LLC

THIS IS NOT A MONUMENTED BOUNDARY SURVEY, IT IS ONLY A
DRAWING INTENDED TO DEPICT THE WELL LOCATION TO SECTION LINES.

DISTANCES TO WELL SHOWN PERPENDICULAR
TO SECTION LINES.

PREPARED BY:		HORSESHOE SURVEYING, LLC PO BOX 150458 LAKEWOOD, CO 80215 (720)872-0196		WELL NAME: BINDER 10-NDU	
DRAWING DATE: 9-17-09				LOCATION: WELD COUNTY, CO N1/2, SEC. 10, T4N, R67W, 6TH P.M.	
FIELD DATE: 10-7-08	BY: TGC	CHKD:		JOB NO.	SHEET NO. 1 OF 1