

Steil Surveying Services, LLC


1102 West 19th Street P.O. BOX 2073

Cheyenne, Wyoming 82009

HYDROLOGY MAP

THIS MAP DOES NOT REPRESENT A BOUNDARY SURVEY

SECTION 34
TOWNSHIP 4 NORTH
RANGE 64 WEST

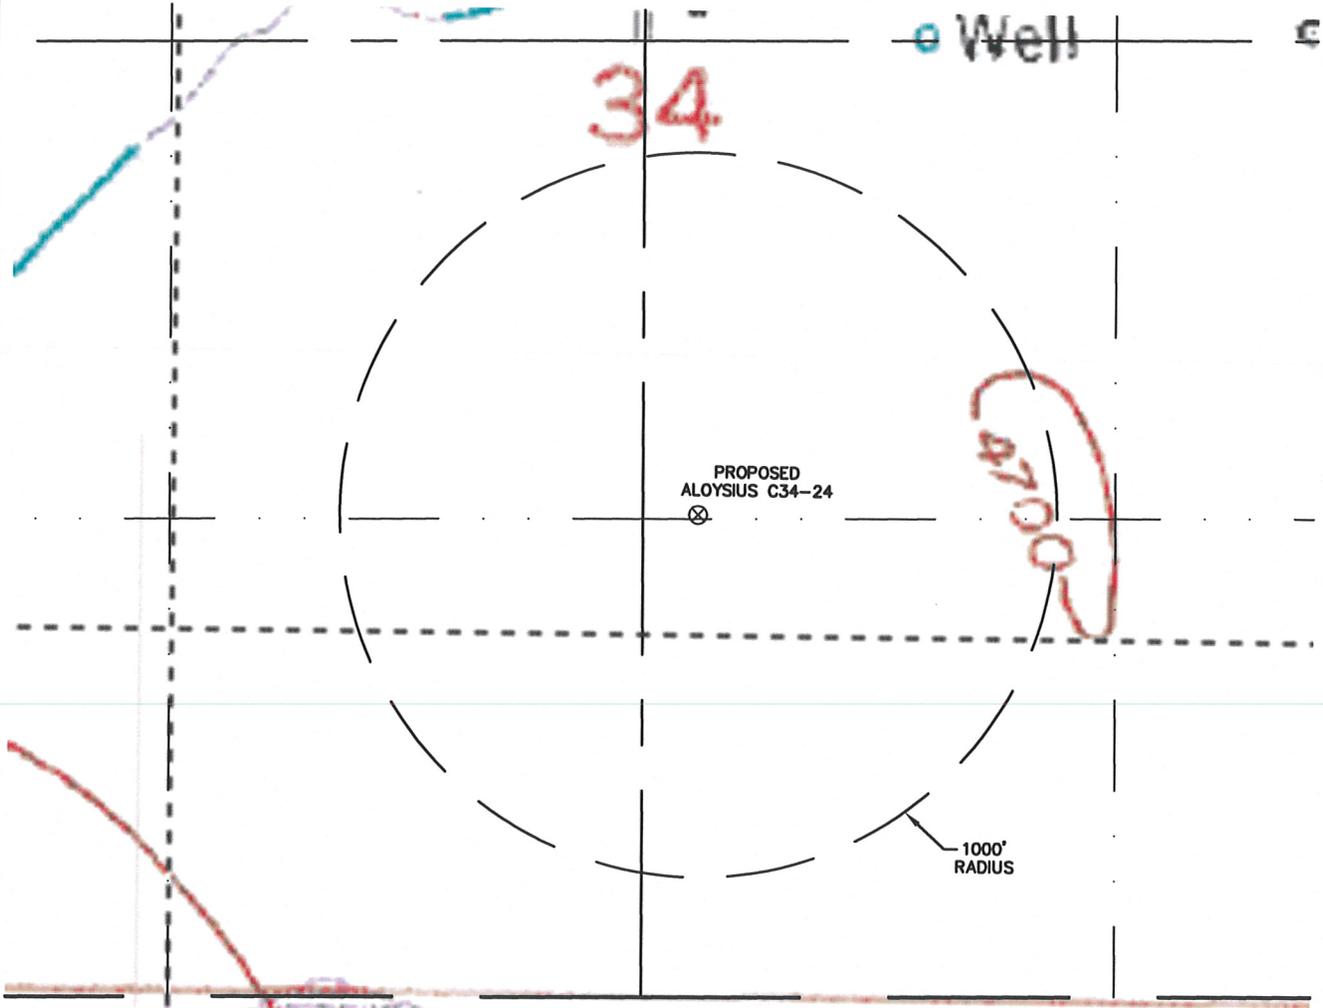

NO VISIBLE SURFACE WATER WITHIN 1000'.

DATE: 09/15/2009

