


LOCATION DRAWING

DALEY LAND SURVEYING, INC. PARKER, CO. 80134 303 953 9841

VISIBLE IMPROVEMENTS SKETCH WCL G05-24

SECTION 5, TOWNSHIP 4 NORTH, RANGE 65 WEST OF THE 6TH PRINCIPLE MERIDIAN

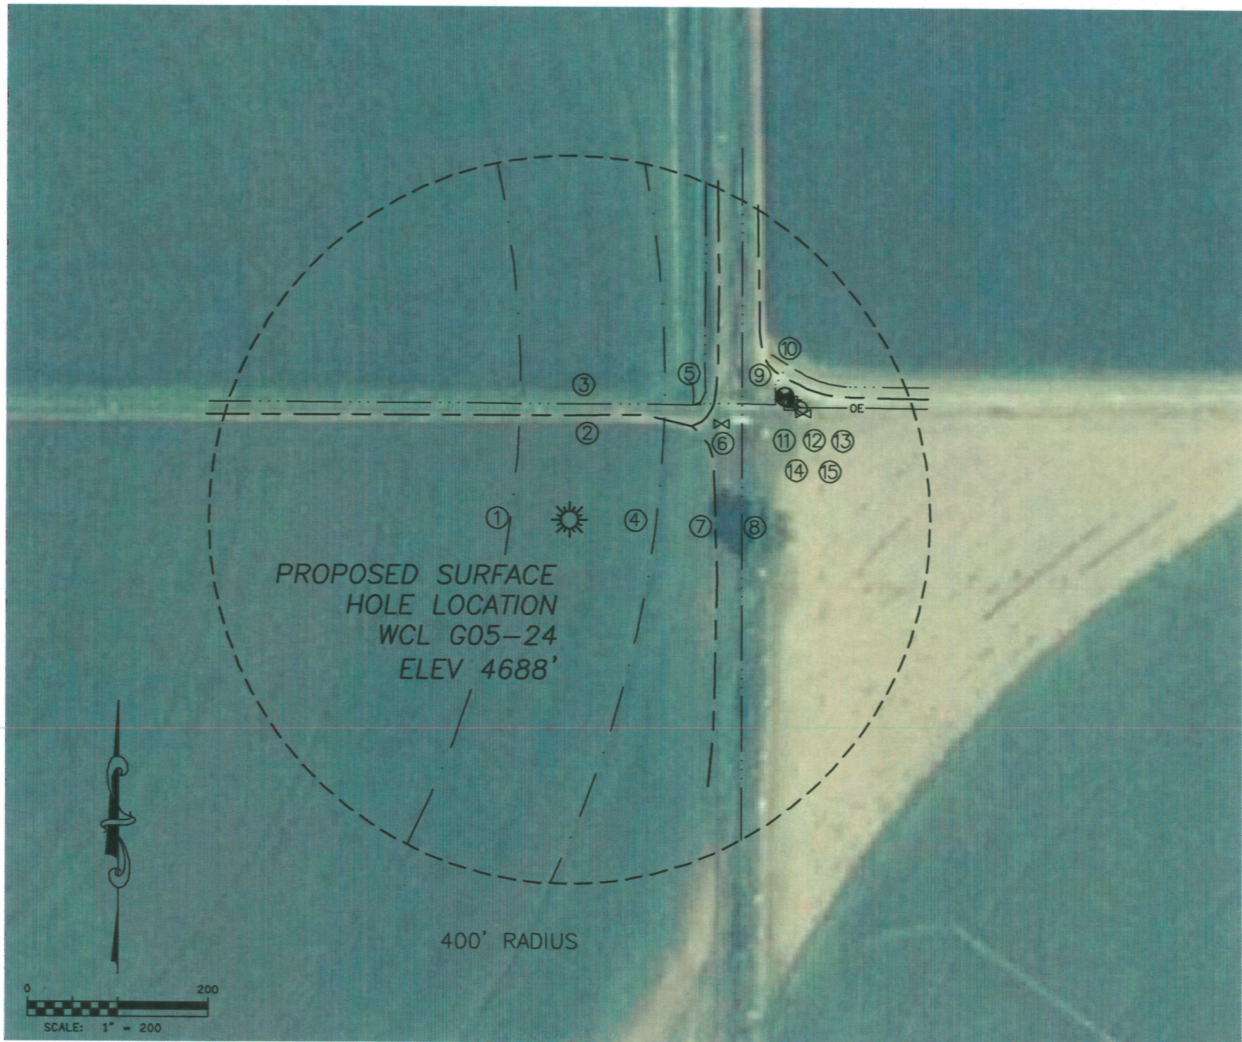

①
PIVOT TRACK
65' WEST

②
CENTERLINE
FIELD ROAD
115' NORTH

③
CONCRETE
DITCH
127' NORTH

④
PIVOT TRACK
96' EAST

⑤
CONCRETE
DITCH
188' NE

⑥
GAS VALVE
199' NE

⑦
CENTERLINE
FIELD ROAD
162' EAST

⑧
IRRIGATION DITCH
192' EAST

⑨
CENTERLINE
FIELD ROAD
279' NE

⑩
CONCRETE
DITCH
294' NE

⑪
WATER WELL
275' NE

⑫
UTILITY POLE
276' NE

⑬
ELECTRIC
TRANSFORMER
278' NE

⑭
UTILITY POLE &
OVERHEAD
ELECTRIC
285' NE

⑮
GAS VALVE
285' NE