



Multi-Well Plan

SITE SKETCH - ALOYSIUS C34-30D

SECTION 28
TOWNSHIP 4 NORTH
RANGE 64 WEST

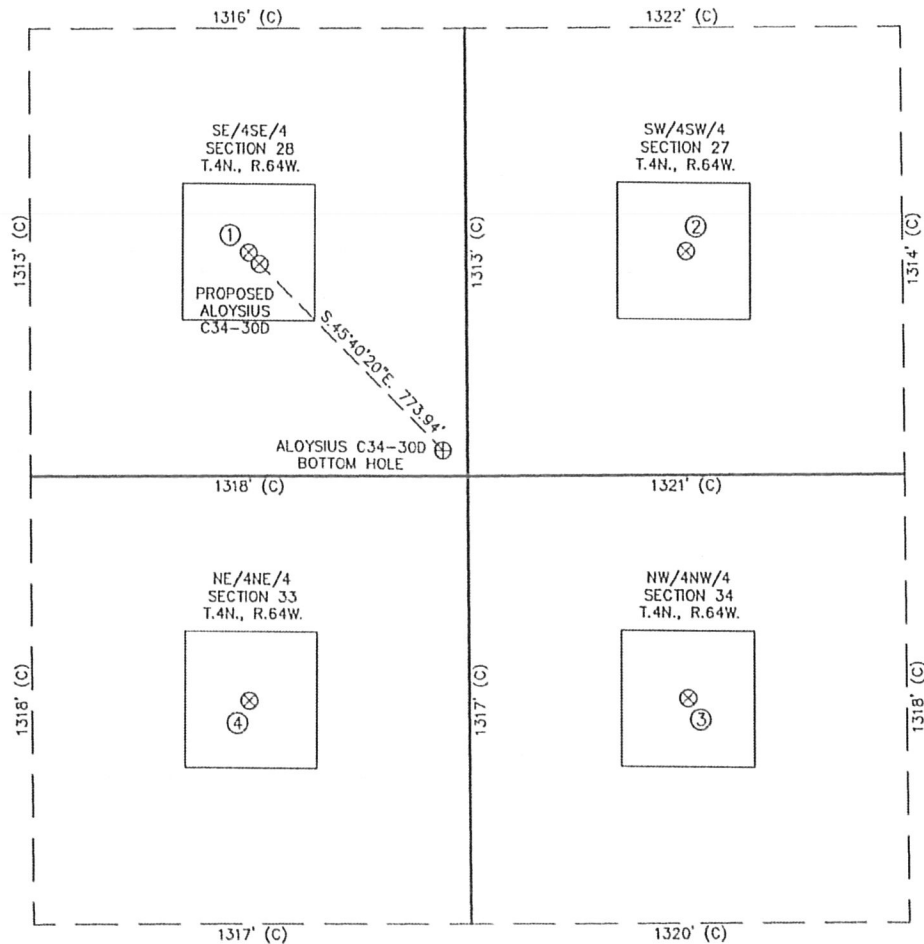

①	②	③	④
THOMPSON 28-16 SE/SE SEC. 28 655' FSL 657' FEL EL 4738' N 40.27801 W 104.54884 PDOP 1.9	LEHFELDT C27-13 SW/SW SEC. 27 655' FSL 667' FWL EL 4710' N 40.27801 W 104.54410 PDOP 2.5	ALOYSIUS C34-1 NW/NW SEC. 34 658' FNL 660' FWL EL 4724' N 40.27441 W 104.54413 PDOP 2.5	LINDSAY C33-14 NE/NE SEC. 33 662' FNL 662' FEL EL 4734' N 40.27439 W 104.54887 PDOP 1.8

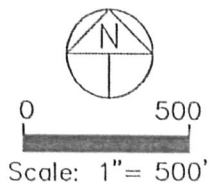

NOTES:

- 1) THIS SKETCH DOES NOT REPRESENT A BOUNDARY SURVEY.
- 2) THE DATUM FOR THE LATITUDES AND LONGITUDES ON THIS SKETCH IS NAD83.