


Leonard 34-21J

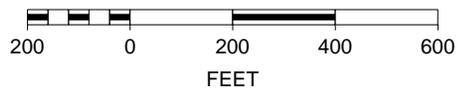

SCALE 1 : 4,465



REVIEWED
By Clay Duke at 9:44 am, Jan 20, 2010