


LOCATION DRAWING

NW1/4 OF SECTION 19, TOWNSHIP 5 NORTH, RANGE 63 WEST, 6TH P.M.


N1/4 CRN SEC. 19

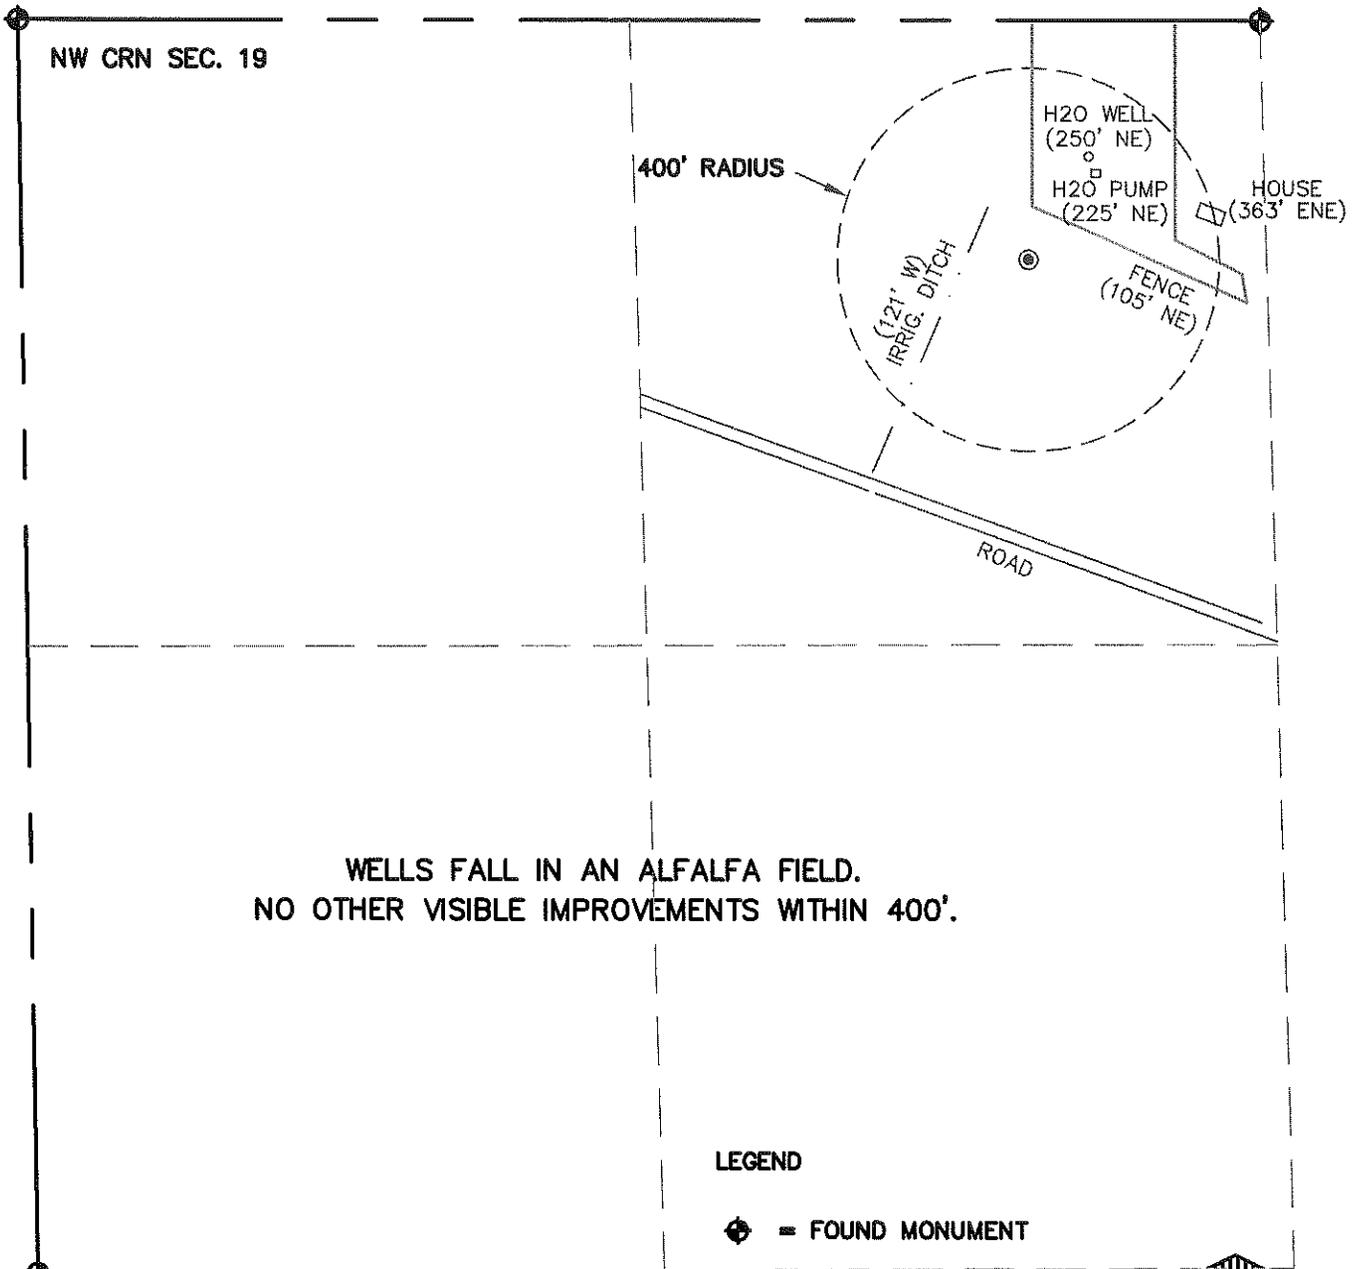

WELLS FALL IN AN ALFALFA FIELD.
NO OTHER VISIBLE IMPROVEMENTS WITHIN 400'.

LEGEND

-  = FOUND MONUMENT
-  = PROPOSED WELL
-  = IMPROVEMENTS (AS LABELED)

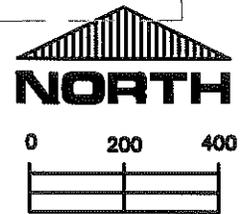

SCALE:

1" = 400'

THIS IS NOT A MONUMENTED BOUNDARY SURVEY, IT IS ONLY A DRAWING INTENDED TO DEPICT VISIBLE IMPROVEMENTS AROUND WELL SITE(S).

PREPARED BY:	HORSESHOE SURVEYING, LLC PO BOX 150458 LAKEWOOD, CO 80215 (720)872-0196	WELL NAME:	SLW 21-19
DRAWING DATE: 1-05-10		LOCATION:	WELD COUNTY, CO NENW, SEC. 19, T5N, R63W, 6TH P.M.
FIELD DATE: 1-05-10			