




EL PASO PRODUCTION



RATON WELL C-81
LATERAL
VERMEJO FIELD, COLORADO

ALL DEPTHS SHOWN ARE
MEASURED DEPTHS

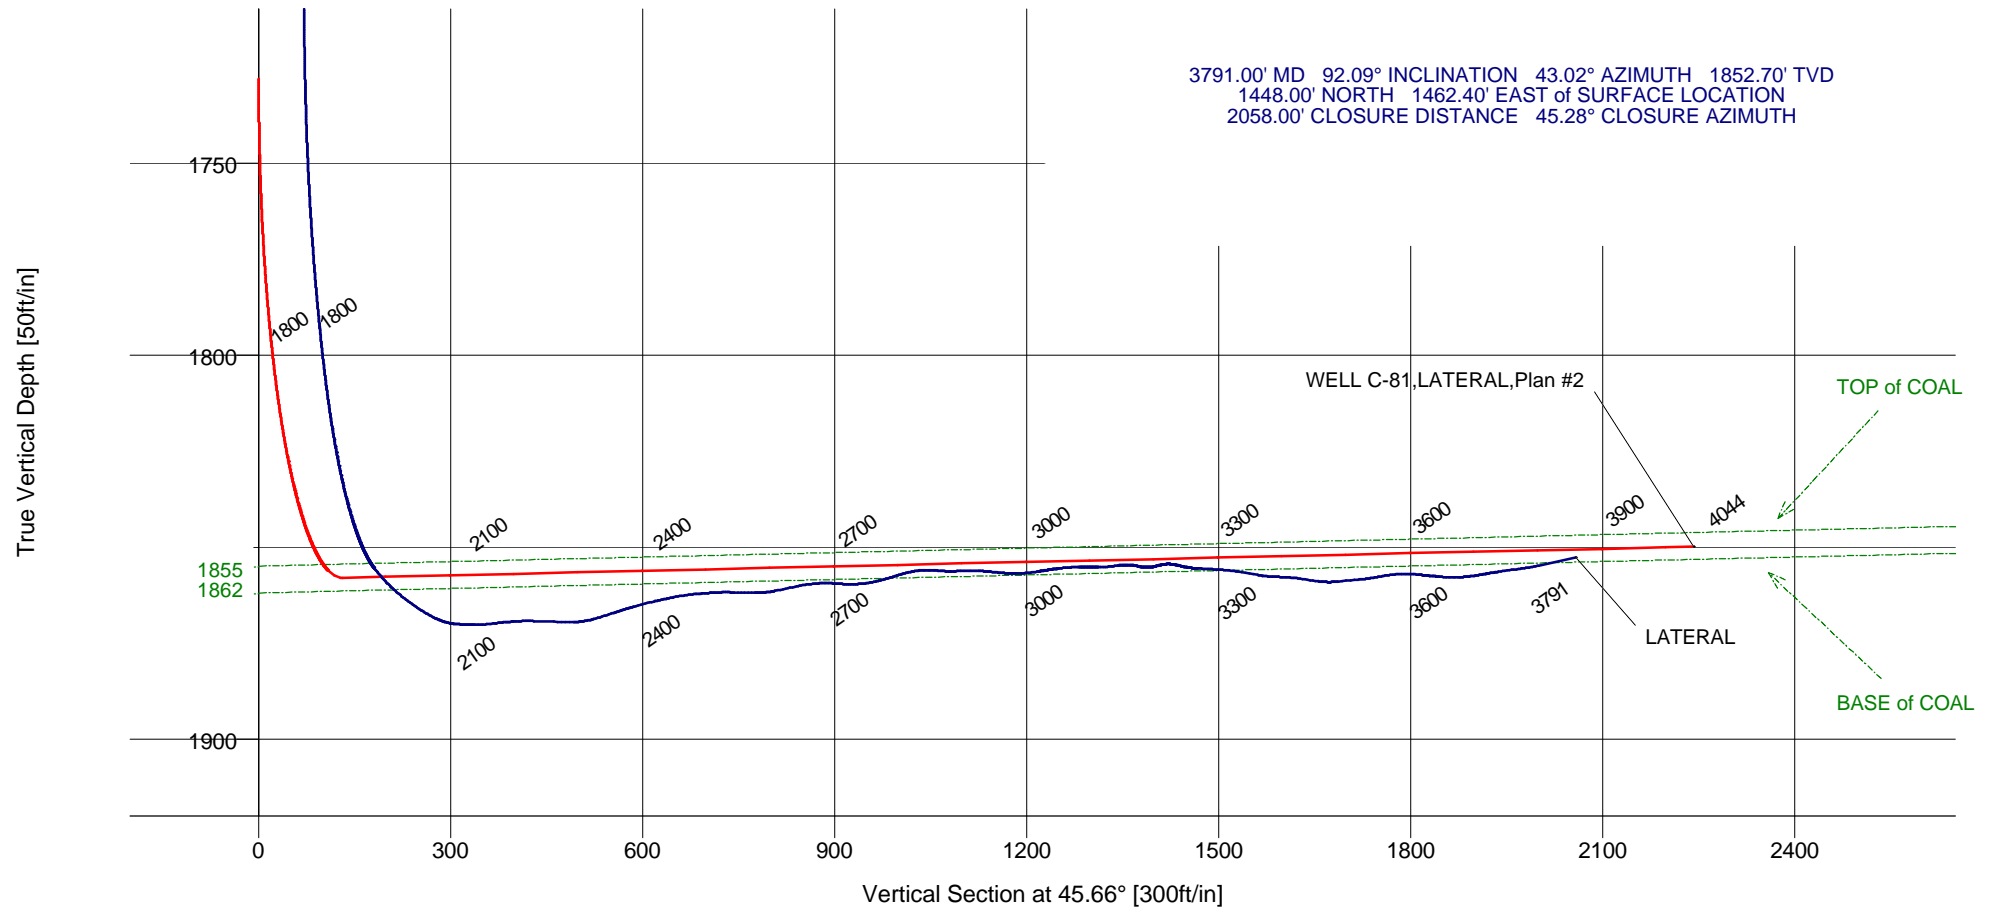

June 24, 2005
Scientific Drilling
281.443.4600