



Union Pacific
Resources

UNION PACIFIC RESOURCES COMPANY

SUBJECT


THOR Unit #1-27

Entire Mineral Lease

SHEET _____ OF _____

DATE _____

BY _____

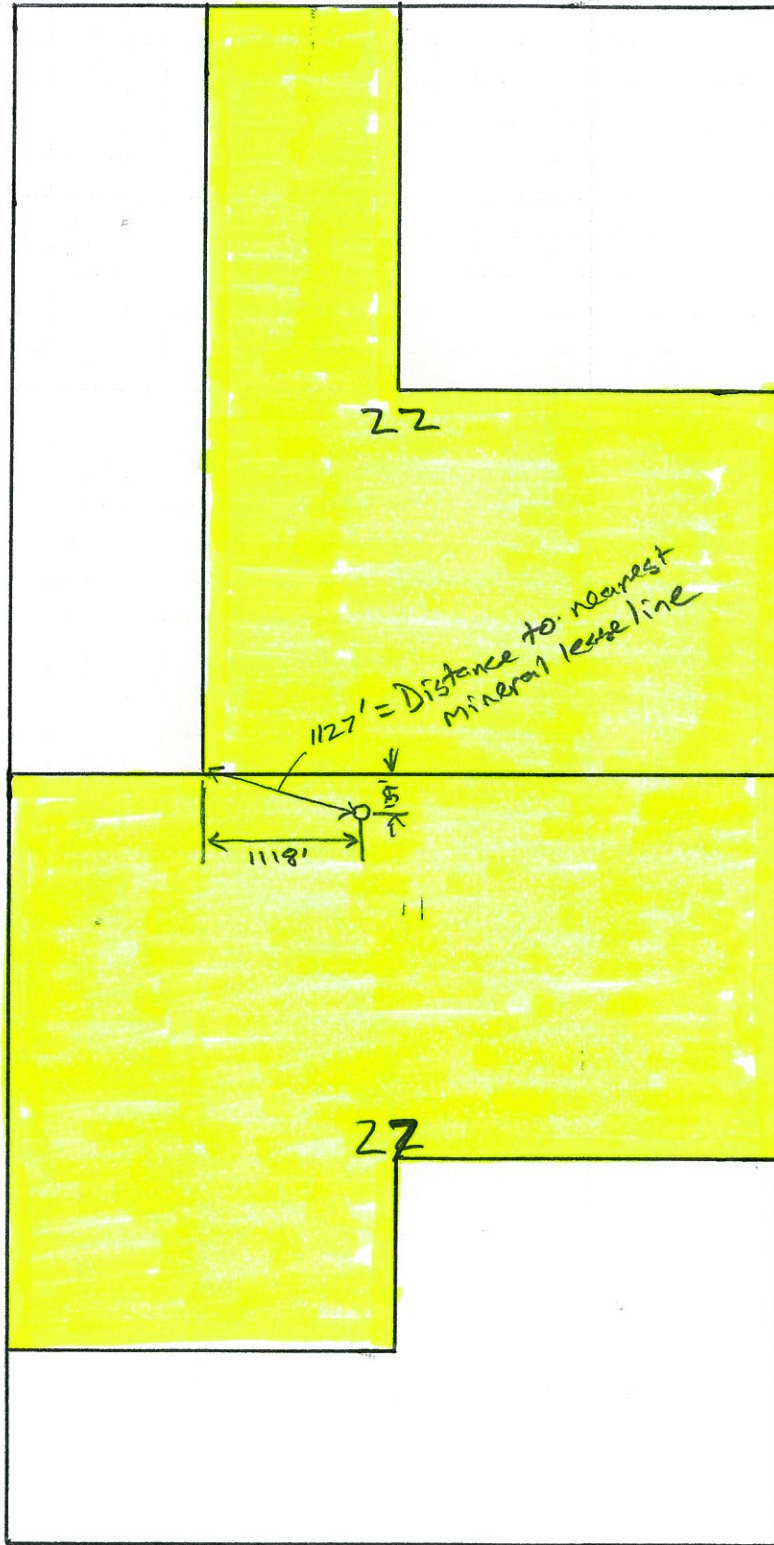

T18S-R45W
KIOWA COUNTY, C