


VISIBLE IMPROVEMENTS
THIS MAP DOES NOT REPRESENT A BOUNDARY SURVEY

SECTION 31
TOWNSHIP 4 NORTH
RANGE 68 WEST

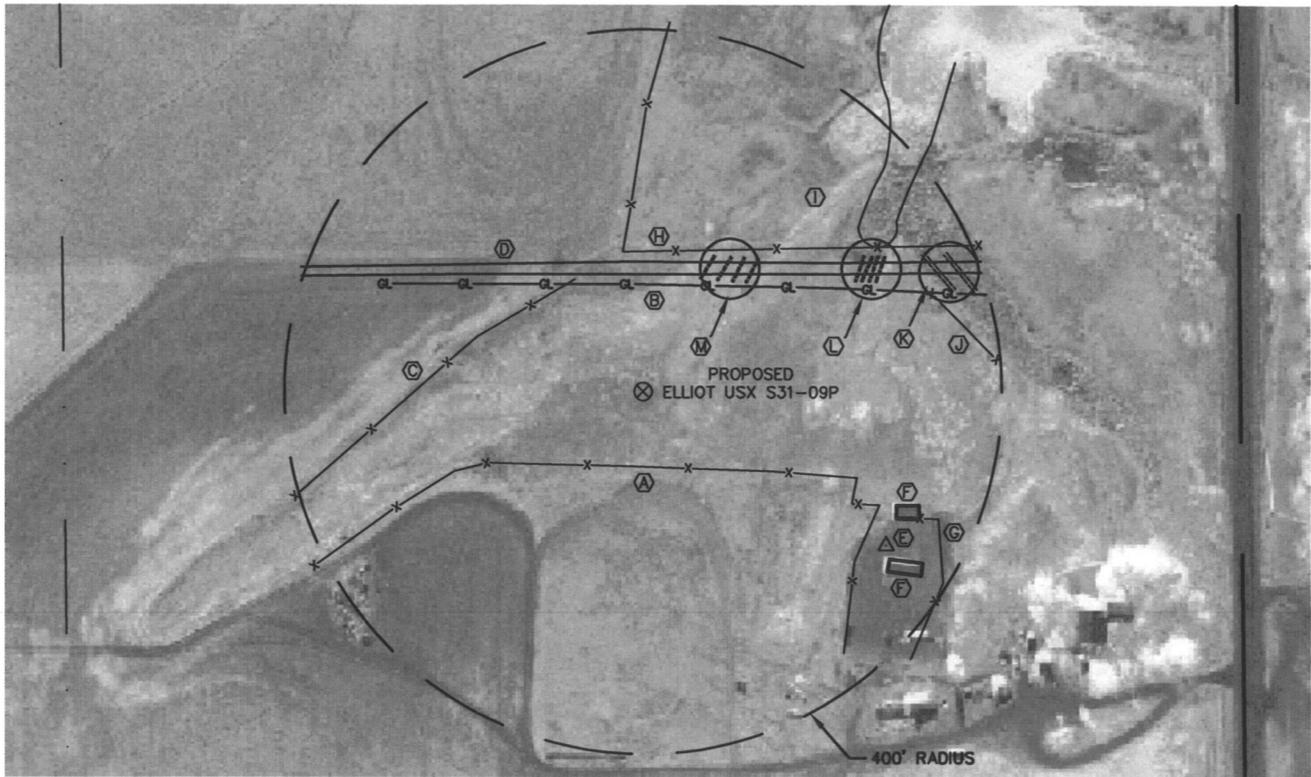

IMPROVEMENTS:

- (A) FENCE LINE - 83' SOUTH
- (B) BURIED GAS LINE - 118' NORTH
- (C) FENCE LINE - 145' NORTHWEST
- (D) DIRT ROAD - 130' NORTH
- (E) FROST FREE NOZZLE - 320' SOUTHEAST
- (F) SHEDS - 309' & 331' SOUTHEAST
- (G) FENCE LINE - 338' SOUTHEAST
- (H) FENCE LINE - 155' NORTH
- (I) POND - 285' NORTHEAST
- (J) FENCE LINE - 341' NORTHEAST
- (K) 48" CMPS - 345' & 368' NORTHEAST
- (L) 24" CMPS - 265', 272', 279' & 286' NORTHEAST
- (M) 24" CMPS - 140', 148', 157' & 166 NORTHEAST

THE NEAREST OVERHEAD POWER LINE IS 500'+/- SOUTHEAST

NOTICE: According to Colorado law you MUST commence any legal action based upon any defect in this W.L.C. within three years after you first discover such defect. In no event may any action based upon any defect in this W.L.C. be commenced more than ten years from this sold date of the certification shown hereon.

