



Bilbo Federal 11-24 (Revised)

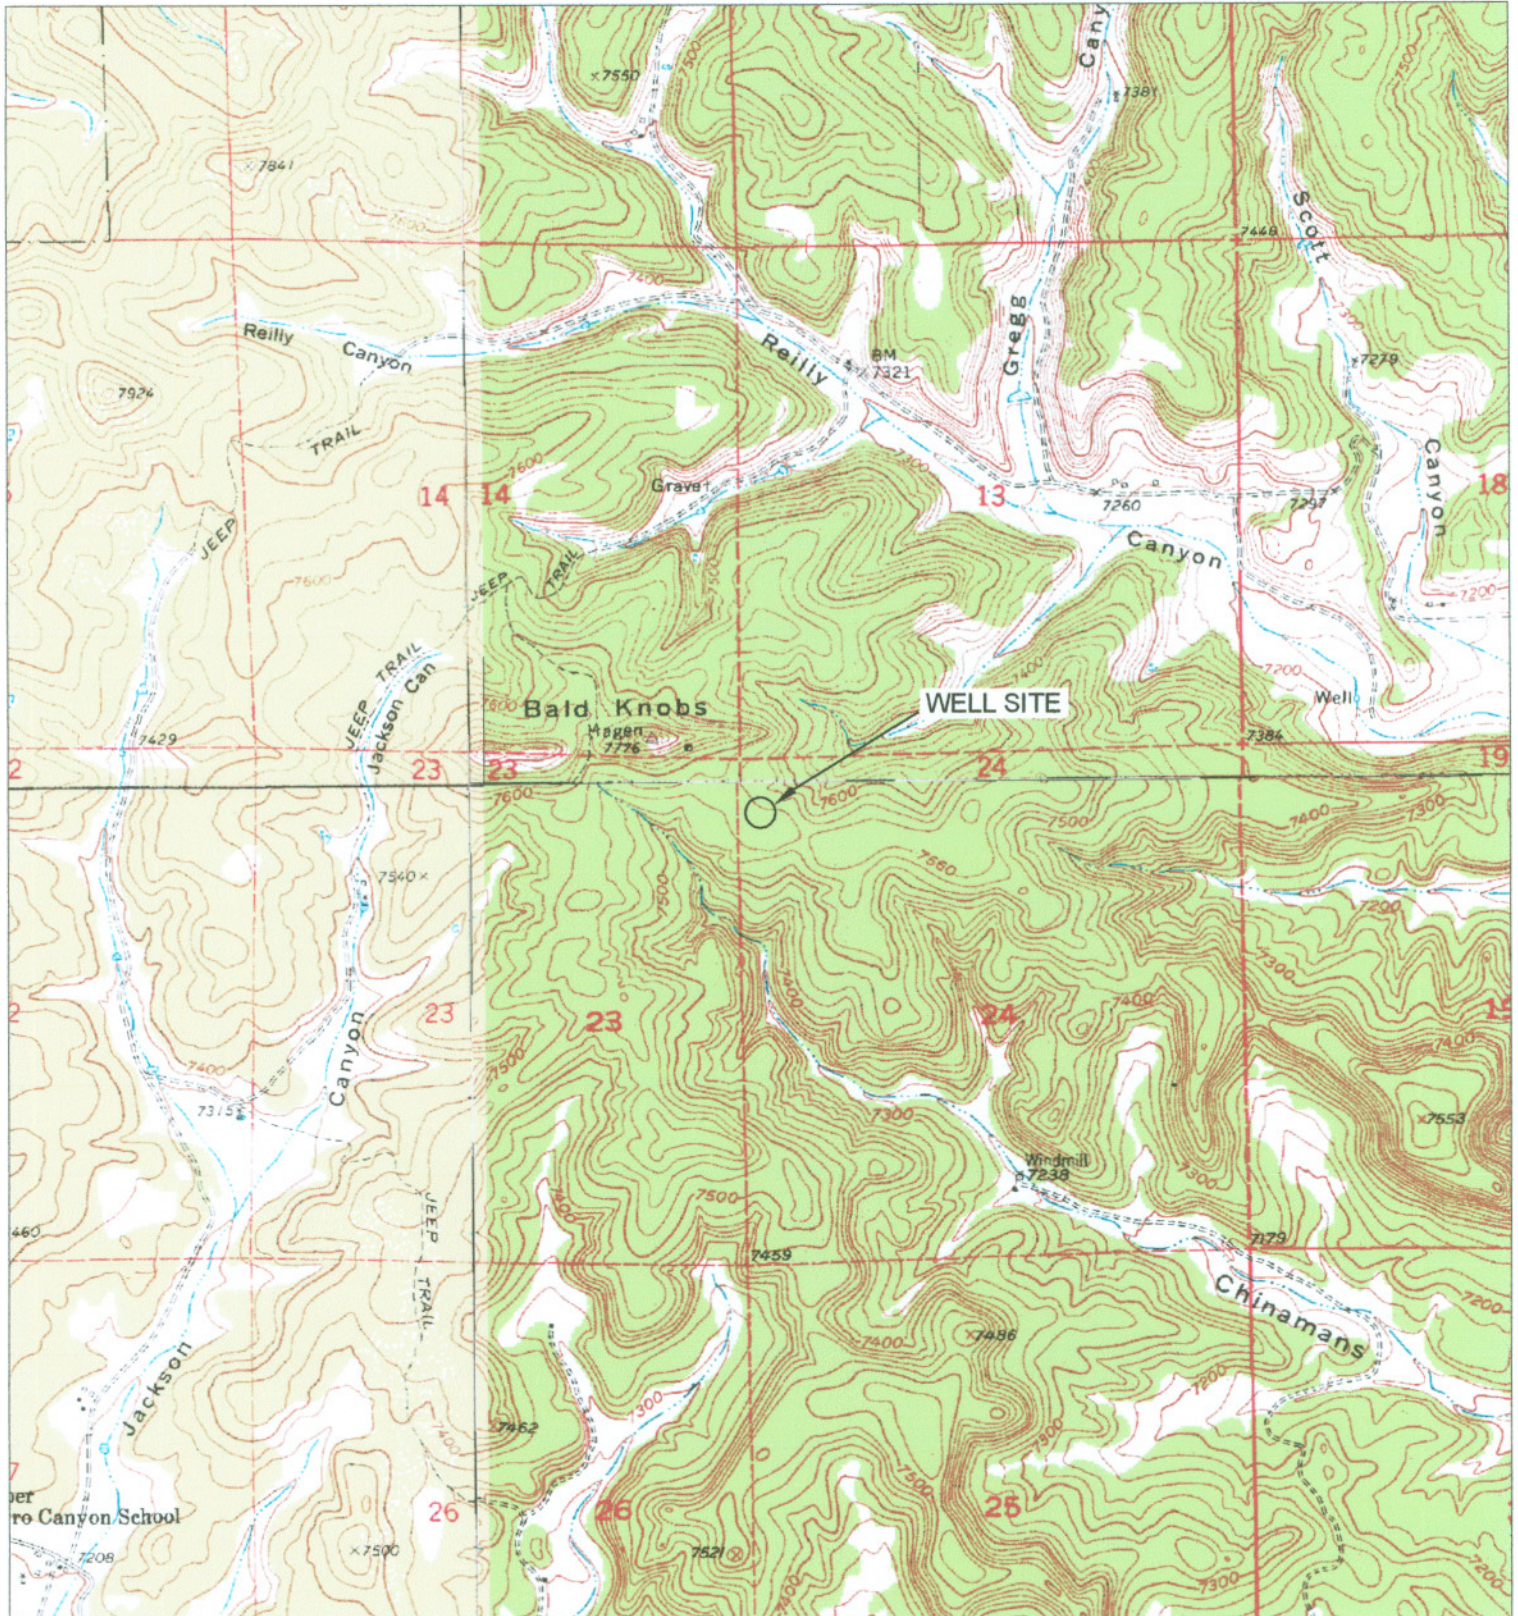

GRAPHIC SCALE

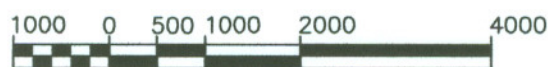

(IN FEET)
1 inch = 2000 ft.

REVISED

SHIELDS SURVEY L^{td}. Co.
Raton, New Mexico 87740
(505)445-1232