


Location *Alibi 23-2*

FROM ALIBI 23-2 TO ALIBI 23-2 TR: *N70°W, 40'±*

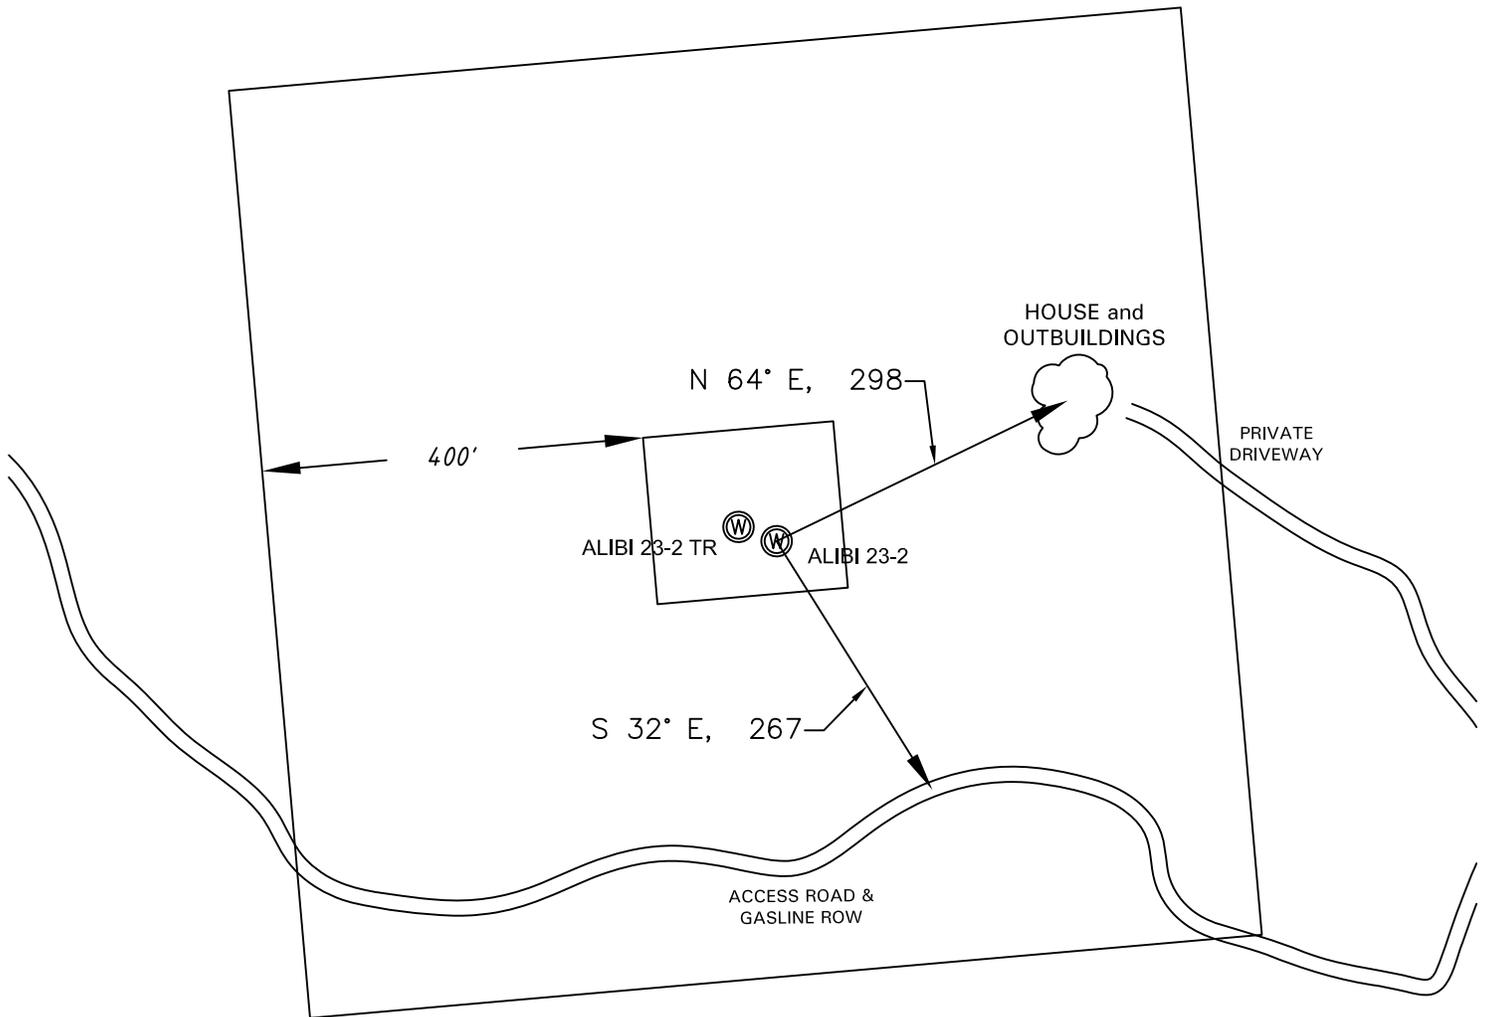

SURFACE USE: *TIMBER*

NOTE:
FOOTAGES GIVEN ARE ONLY ESTIMATES BASED ON SUBDIVISION PLATS AND TIED TO EXISTING CONTROL. A FULL BOUNDARY SURVEY IS REQUIRED TO DETERMINE TRUE SUBDIVISION LOT AND ROAD LOCATIONS, DISTANCES AND AREA OR FOOTAGE CALCULATIONS.

DATE: January 18, 2010

GRAPHIC SCALE



(IN FEET)
1 inch = 200 ft.

SHIELDS SURVEY Ltd. Co.
Raton, New Mexico 87740
(575)445-1232