

State of Colorado
Oil and Gas Conservation Commission

1120 Lincoln Street, Suite 801, Denver, Colorado 80203 (303)894-2100 Fax:(303)894-2109



FOR OGCC USE ONLY

Spill report taken by: _____

FACILITY ID: _____

SPILL/RELEASE REPORT

This form is to be submitted by the party responsible for the oil and gas spill or release. Any spill or release which may impact waters of the State must be reported as soon as practicable; any spill over 20 bbls must be reported within 24 hours and all spills over five bbls must be reported within ten days. Submit a Site Investigation and Remediation Workplan (Form 27) when requested by the Director.

OPERATOR INFORMATION

Name of Operator: _____ OGCC Operator No: _____	Phone Numbers
Address: _____	No: _____
City: _____ State: _____ Zip: _____	Fax: _____
Contact Person: _____	E-Mail: _____

DESCRIPTION OF SPILL OR RELEASE

Date of Incident: _____ Facility Name & No.: _____	County: _____
Type of Facility (well, tank battery, flow line, pit): _____	QtrQtr: _____ Section: _____
Well Name and Number: _____	Township: _____ Range: _____
API Number: _____	Meridian: _____
Specify volume spilled and recovered (in bbls) for the following materials:	
Oil spilled: _____ Oil recov'd: _____ Water spilled: _____ Water recov'd: _____ Other spilled: _____ Other recov'd: _____	
Ground Water impacted? Yes No	Surface Water impacted? Yes No
Contained within berm? Yes No	Area and vertical extent of spill: _____ x _____
Current land use: _____	Weather conditions: _____
Soil/geology description: _____	
IF LESS THAN A MILE , report distance IN FEET to nearest.... Surface water: _____ wetlands: _____ buildings: _____	
Livestock: _____ water wells: _____ Depth to shallowest ground water: _____	
Cause of spill (e.g., equipment failure, human error, etc.): _____ Detailed description of the spill/release incident: _____	

CORRECTIVE ACTION

Describe immediate response (how stopped, contained and recovered):

Describe any emergency pits constructed:

How was the extent of contamination determined:

Further remediation activities proposed (attach separate sheet if needed):



Describe measures taken to prevent problem from reoccurring:

OTHER NOTIFICATIONS

List the parties and agencies notified (County, BLM, EPA, DOT, Local Emergency Planning Coordinator or other).

Date	Agency	Contact	Phone	Response


Spill/Release Tracking No: _____

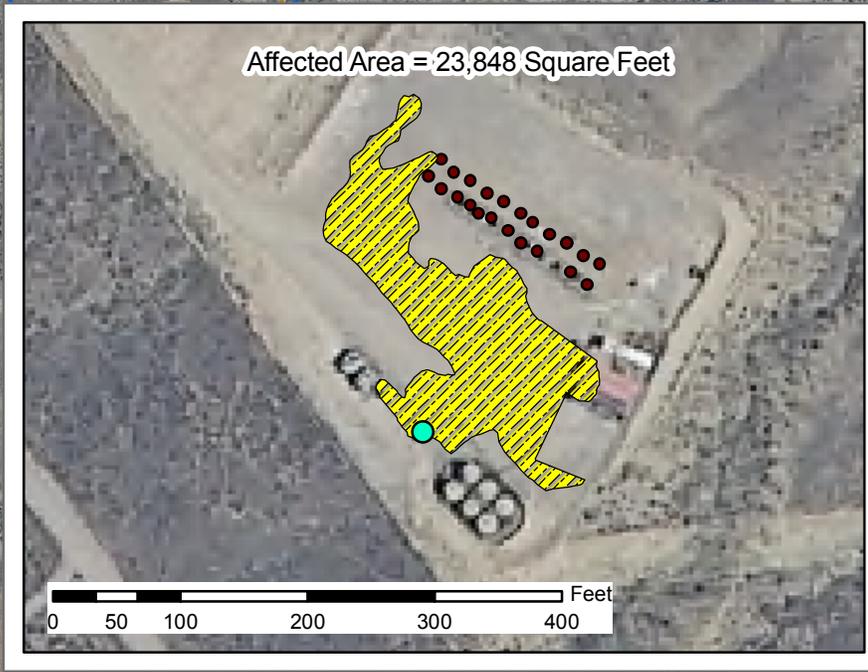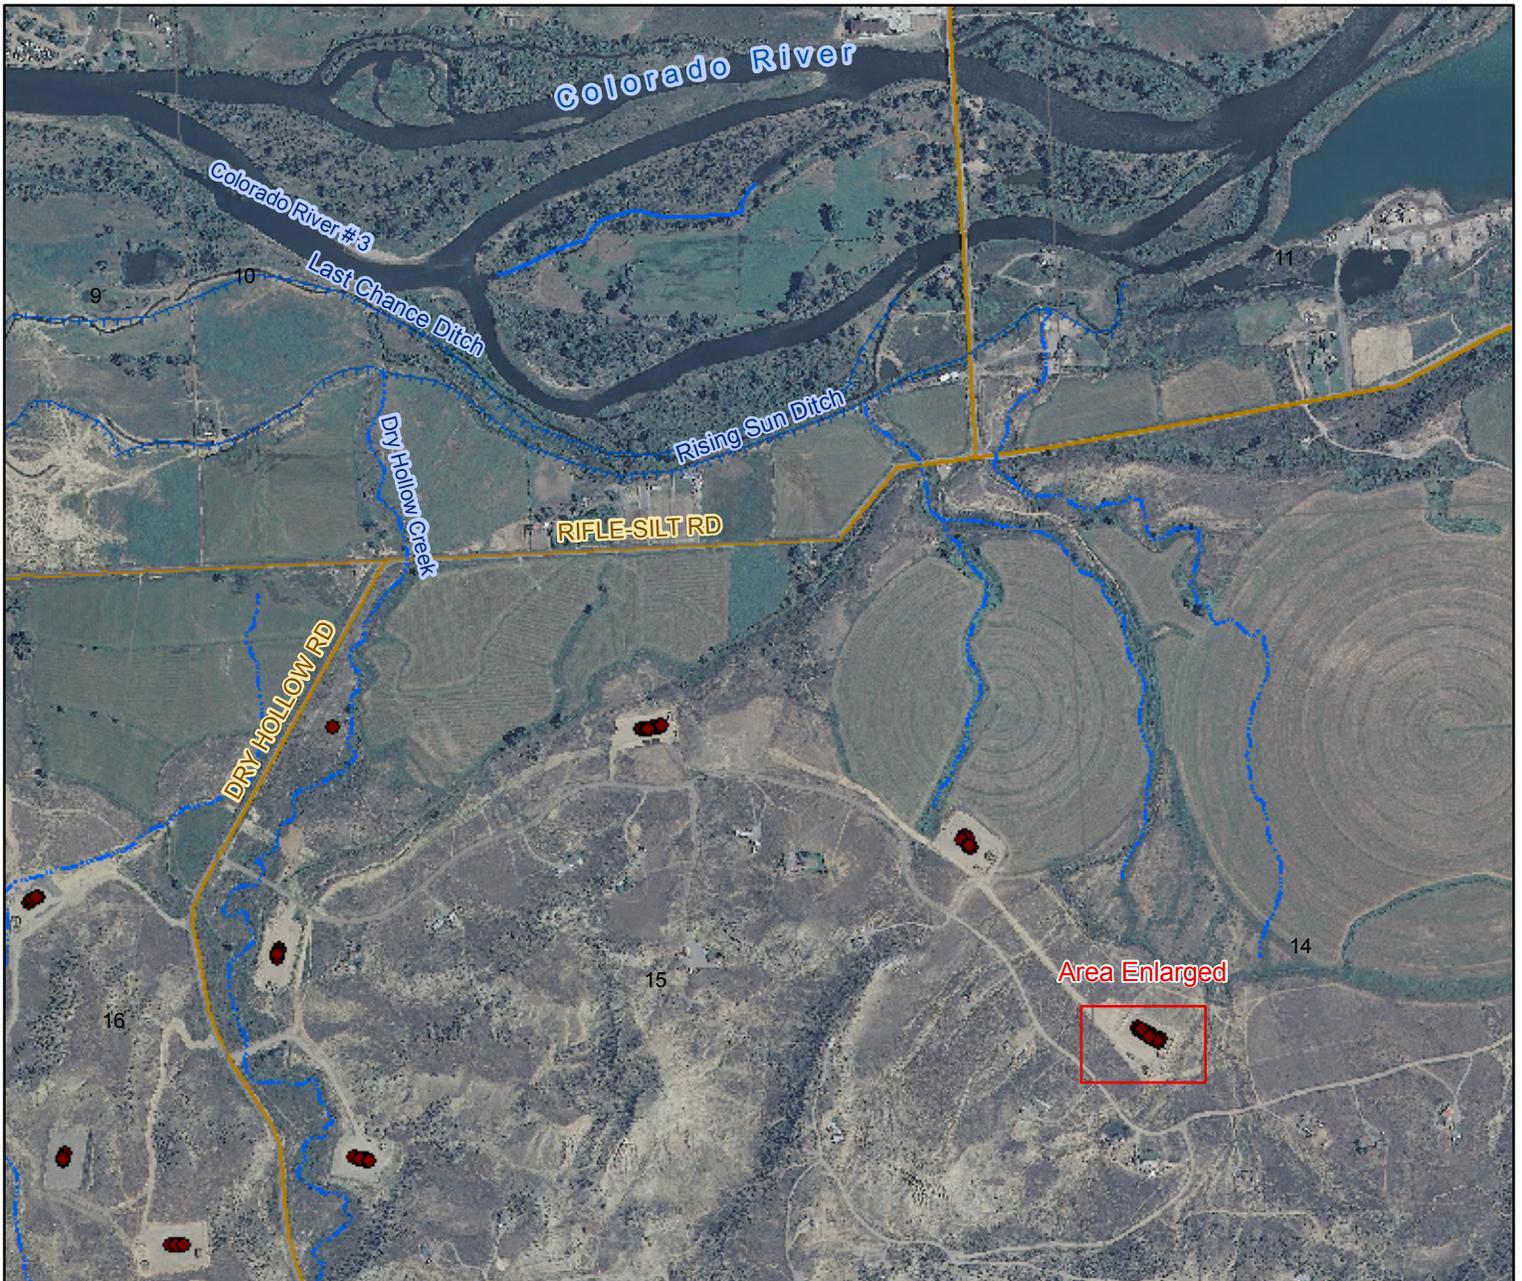

Spill Location Map
Location: Valley Farms F Pad
Antero Resources Piceance Corp.

Legend

● Well Location	Hydrography
● Sample Location	— Perennial Stream
▨ Affected Area	- - - Intermittent Stream
	- - - - Ditch/Canal
	Transportation Features
	— Highways
	— Public Roads

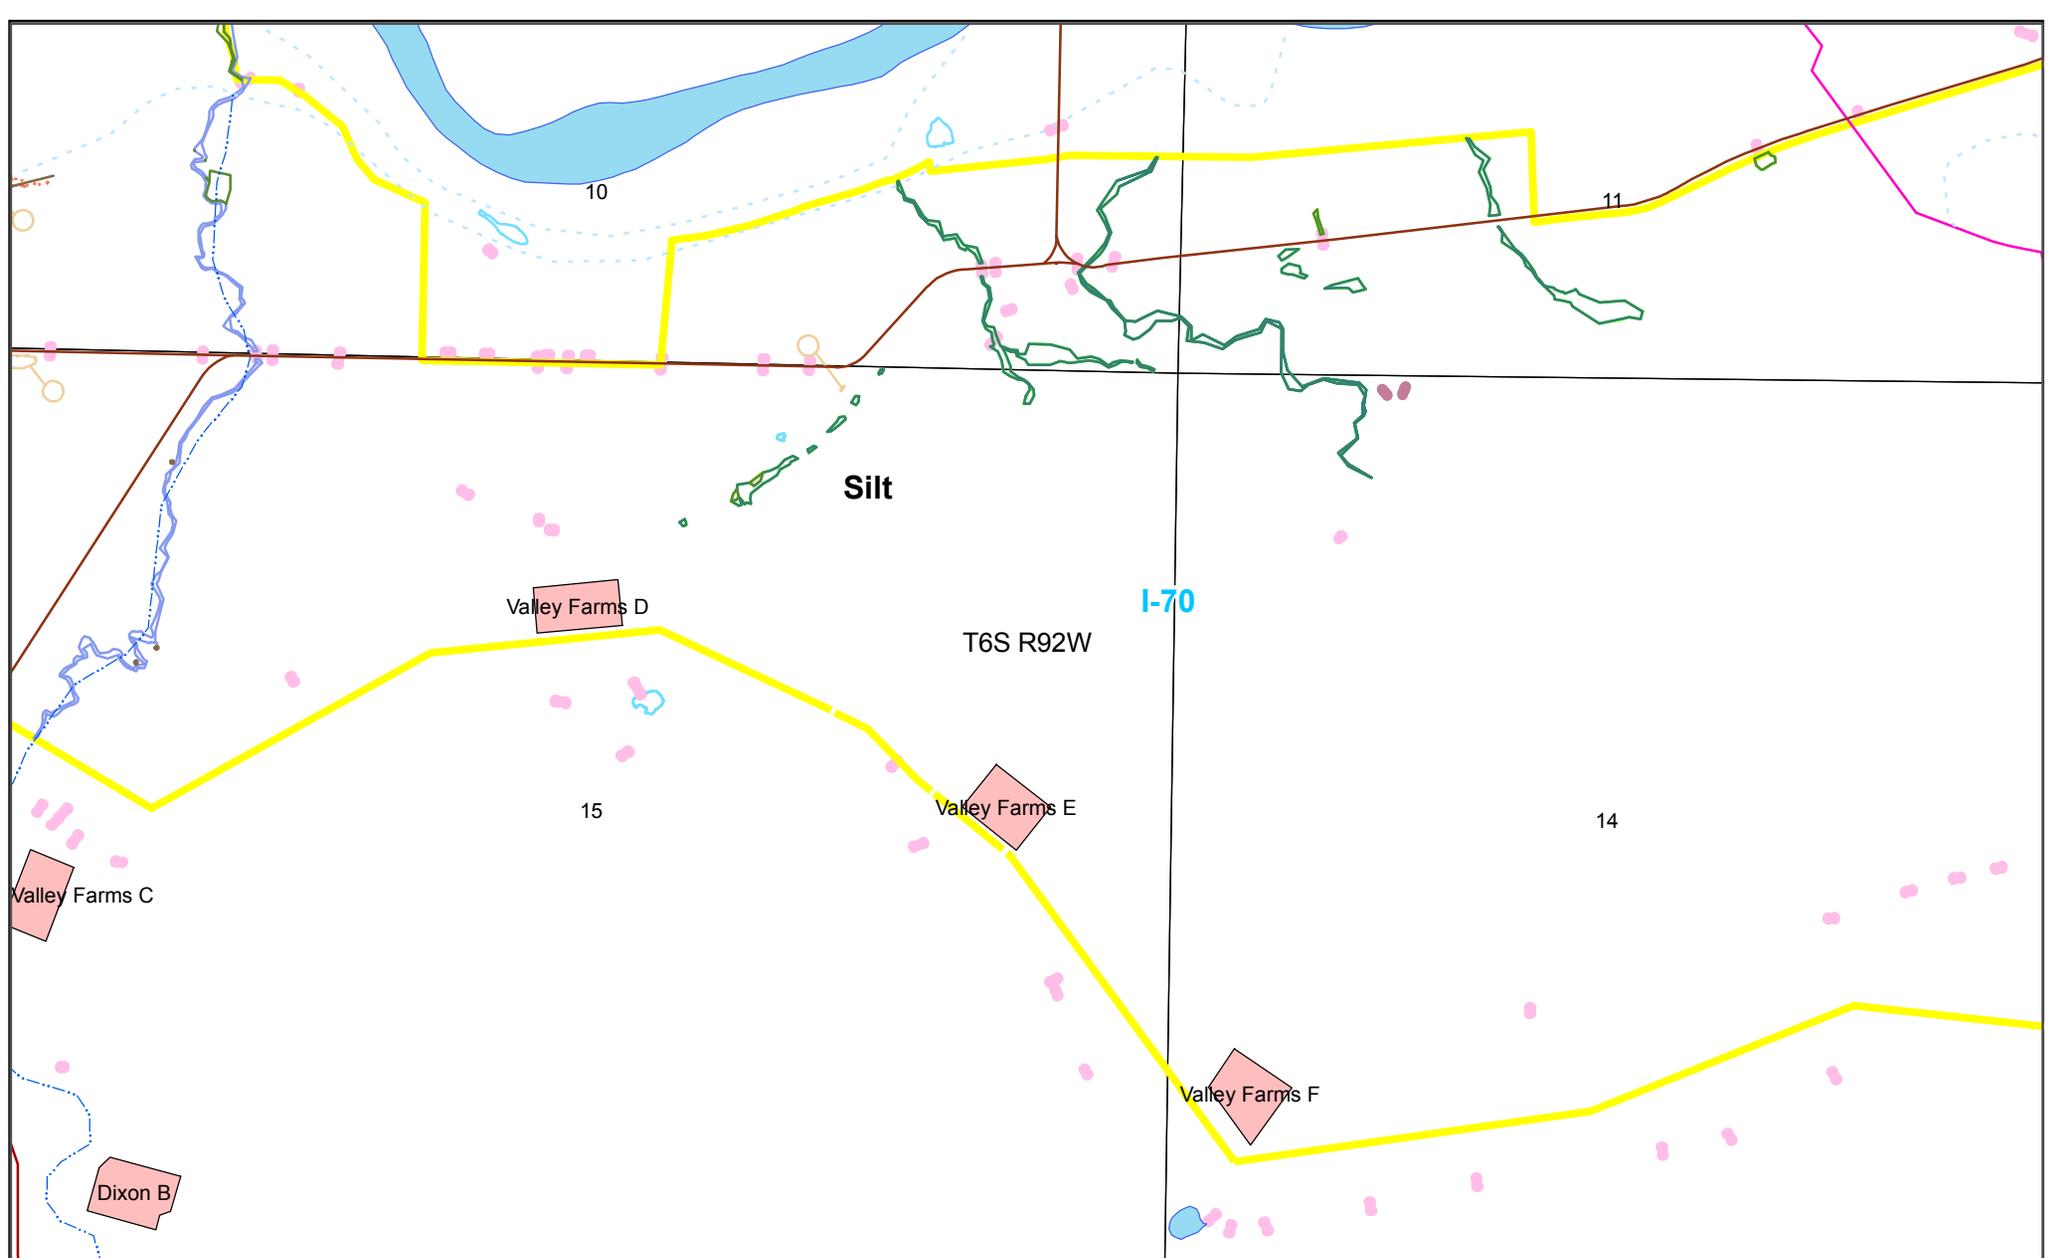

Antero Resources Piceance Corp.

	Name	Address	Phone Number
Company	Antero Resources	1625 17th Street Denver, CO 80202	(303)357-7310
Map Preparer	Kelly Bruchez	1625 17th Street Denver, CO 80202	(303)357-7310



0 220 440 880 Feet

Valley Farms Wetlands Map

CDP_BUILT_PADS	CULVERT	LAKE	WER Revised Wetlands	WETOUTL
AQUATIC	DAM	WER 1999 Wetlands Converted to Uplands	WER Soil Pits	Wetlands along Colorado River South Bank
STUDY BOUNDARY	EXPNPTWETLANDS	WER Revised WLS surveyed 1999	WER Wetland NonJurisdictional 062005	