


KING SURVEYORS, INC. 650 GARDEN DR. WINDSOR, CO 80550  
LOCATION DRAWING

SECTION: 14  
TOWNSHIP: 2S  
RANGE: 45W

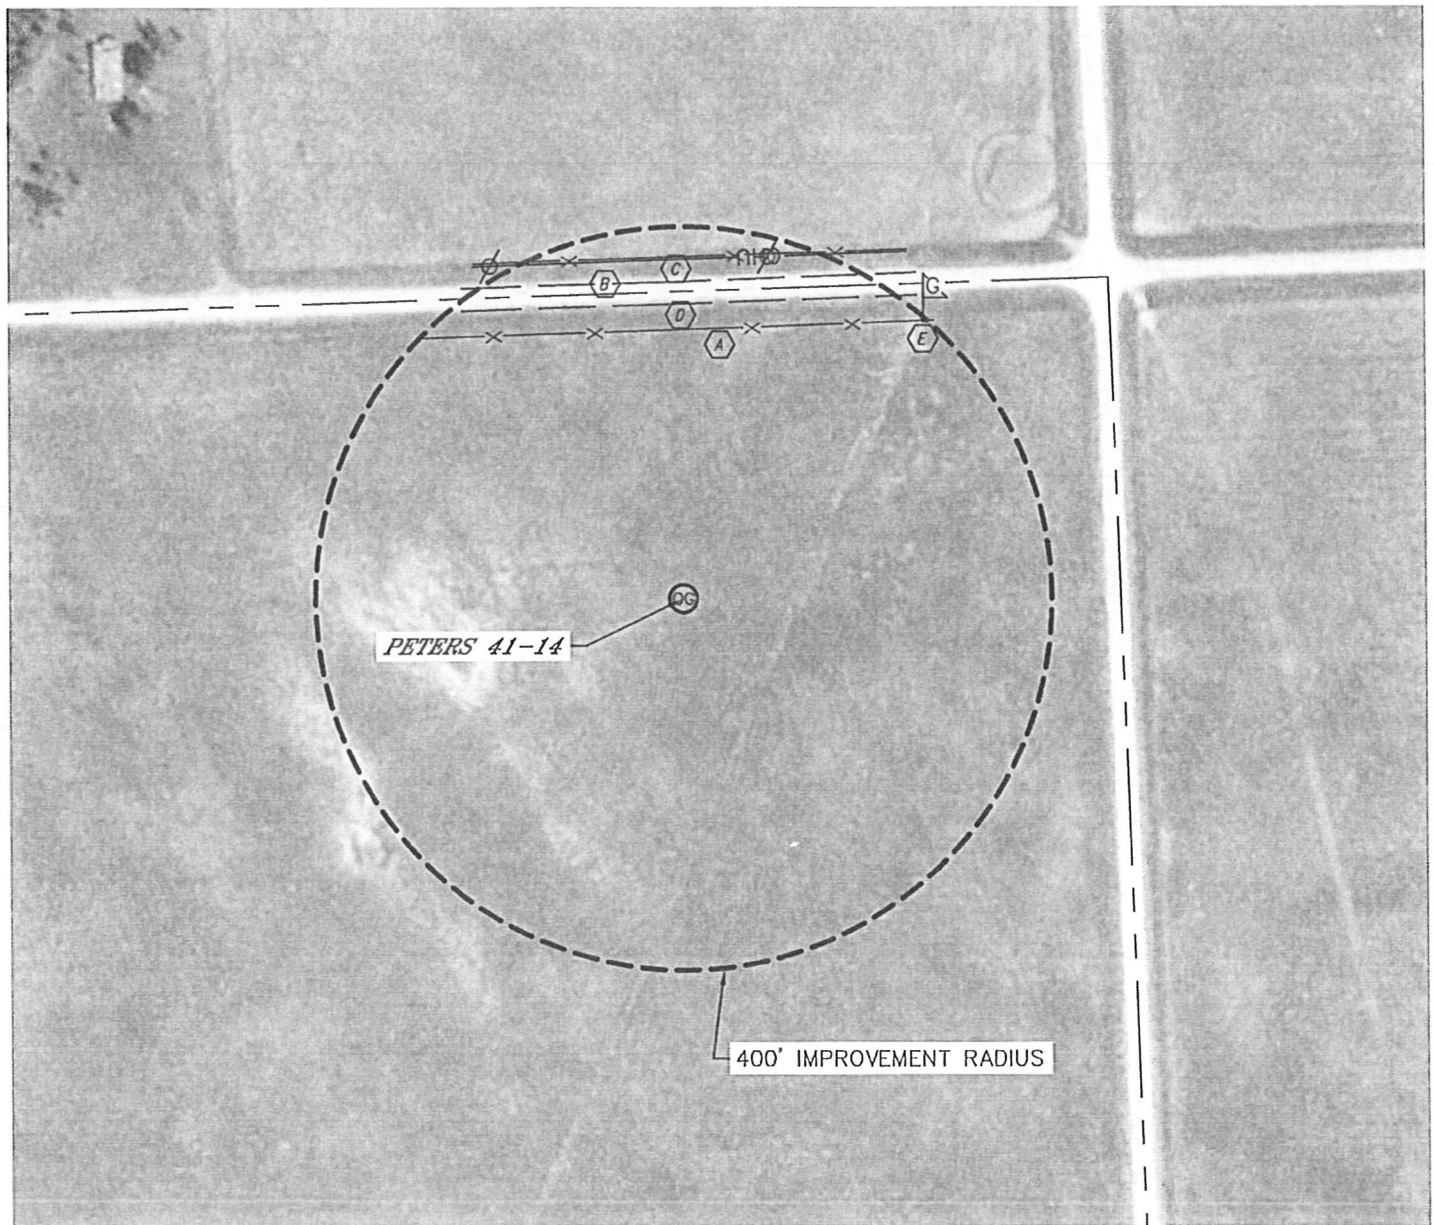

IMPROVEMENTS:

- (A) FENCE 289' NORTH, 367' NORTH
- (B) PROPERTY LINE 330' NORTH
- (C) OVERHEAD UTILITY LINE 365' NORTH
- (D) COUNTY ROAD 317' NORTH
- (E) GAS MARKER 397' NORTHEAST

