


# Johnson 13-13J



SCALE 1 : 9,614

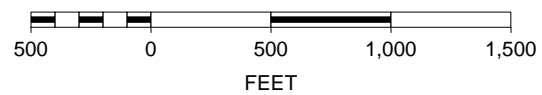

**REVIEWED**

By Clay Duke at 9:07 am, Feb 11, 2010

Thursday, February 11, 2010 7:31 AM