


EOG RESOURCES, INC.  
RECLAMATION DIAGRAM FOR  
RANDALL CREEK #01-28H  
SECTION 28, T12N, R62W, 6th P.M.  
325' FSL 1600' FEL

FIGURE #4

SCALE: 1" = 60'  
DATE: 01-25-10  
DRAWN BY: D.P.

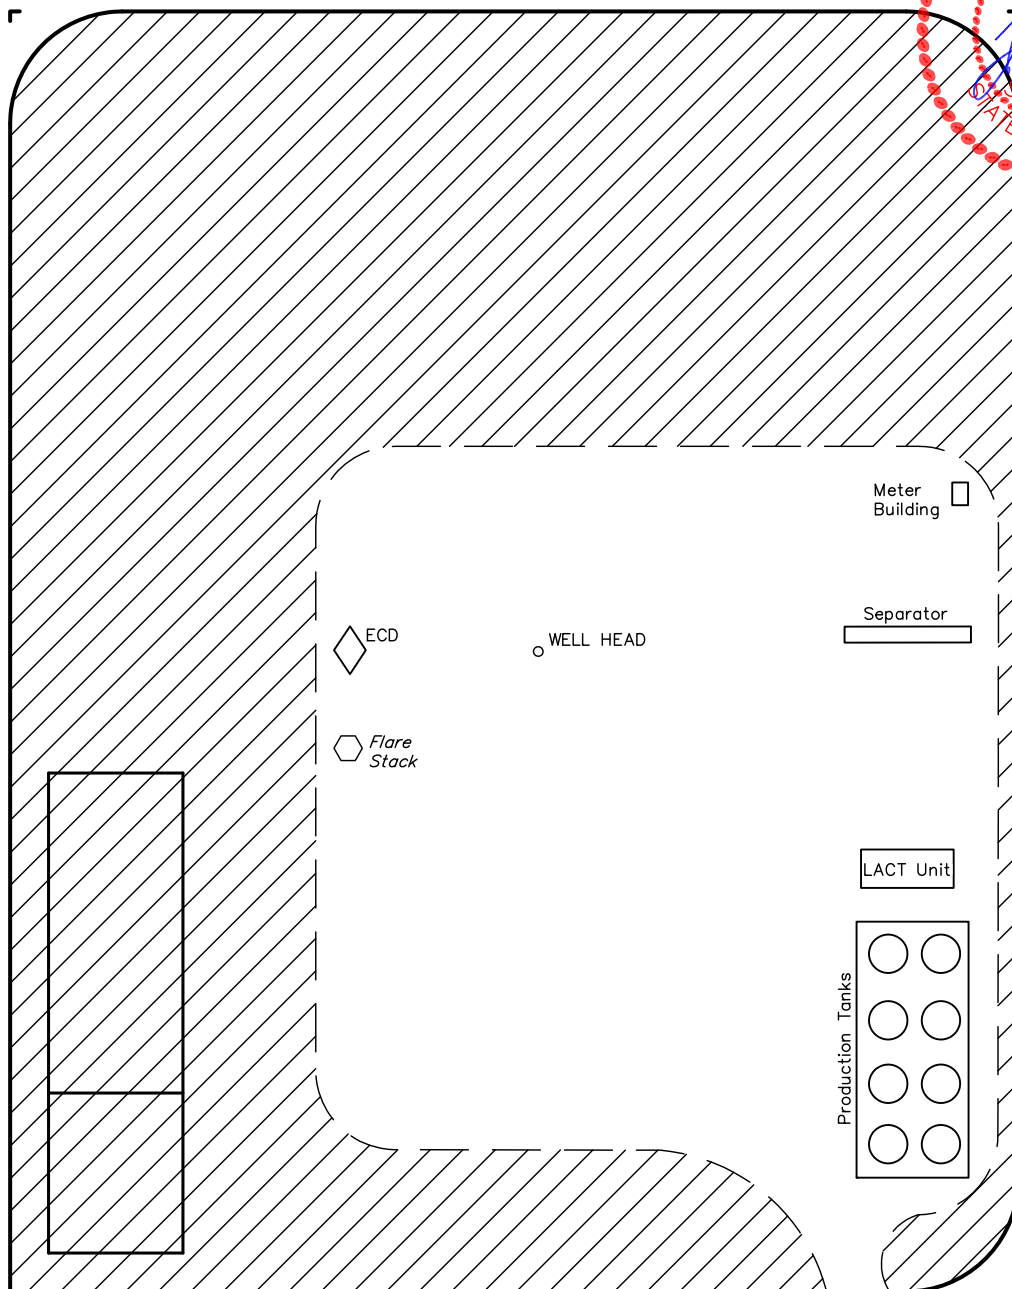

APPROXIMATE ACREAGES  
UN-RECLAIMED AREA =  $\pm$  1.115 ACRES

 RECLAIMED AREA