



# Stroh 12-22, Loc. #: 310848, 664N67W /22SWNW

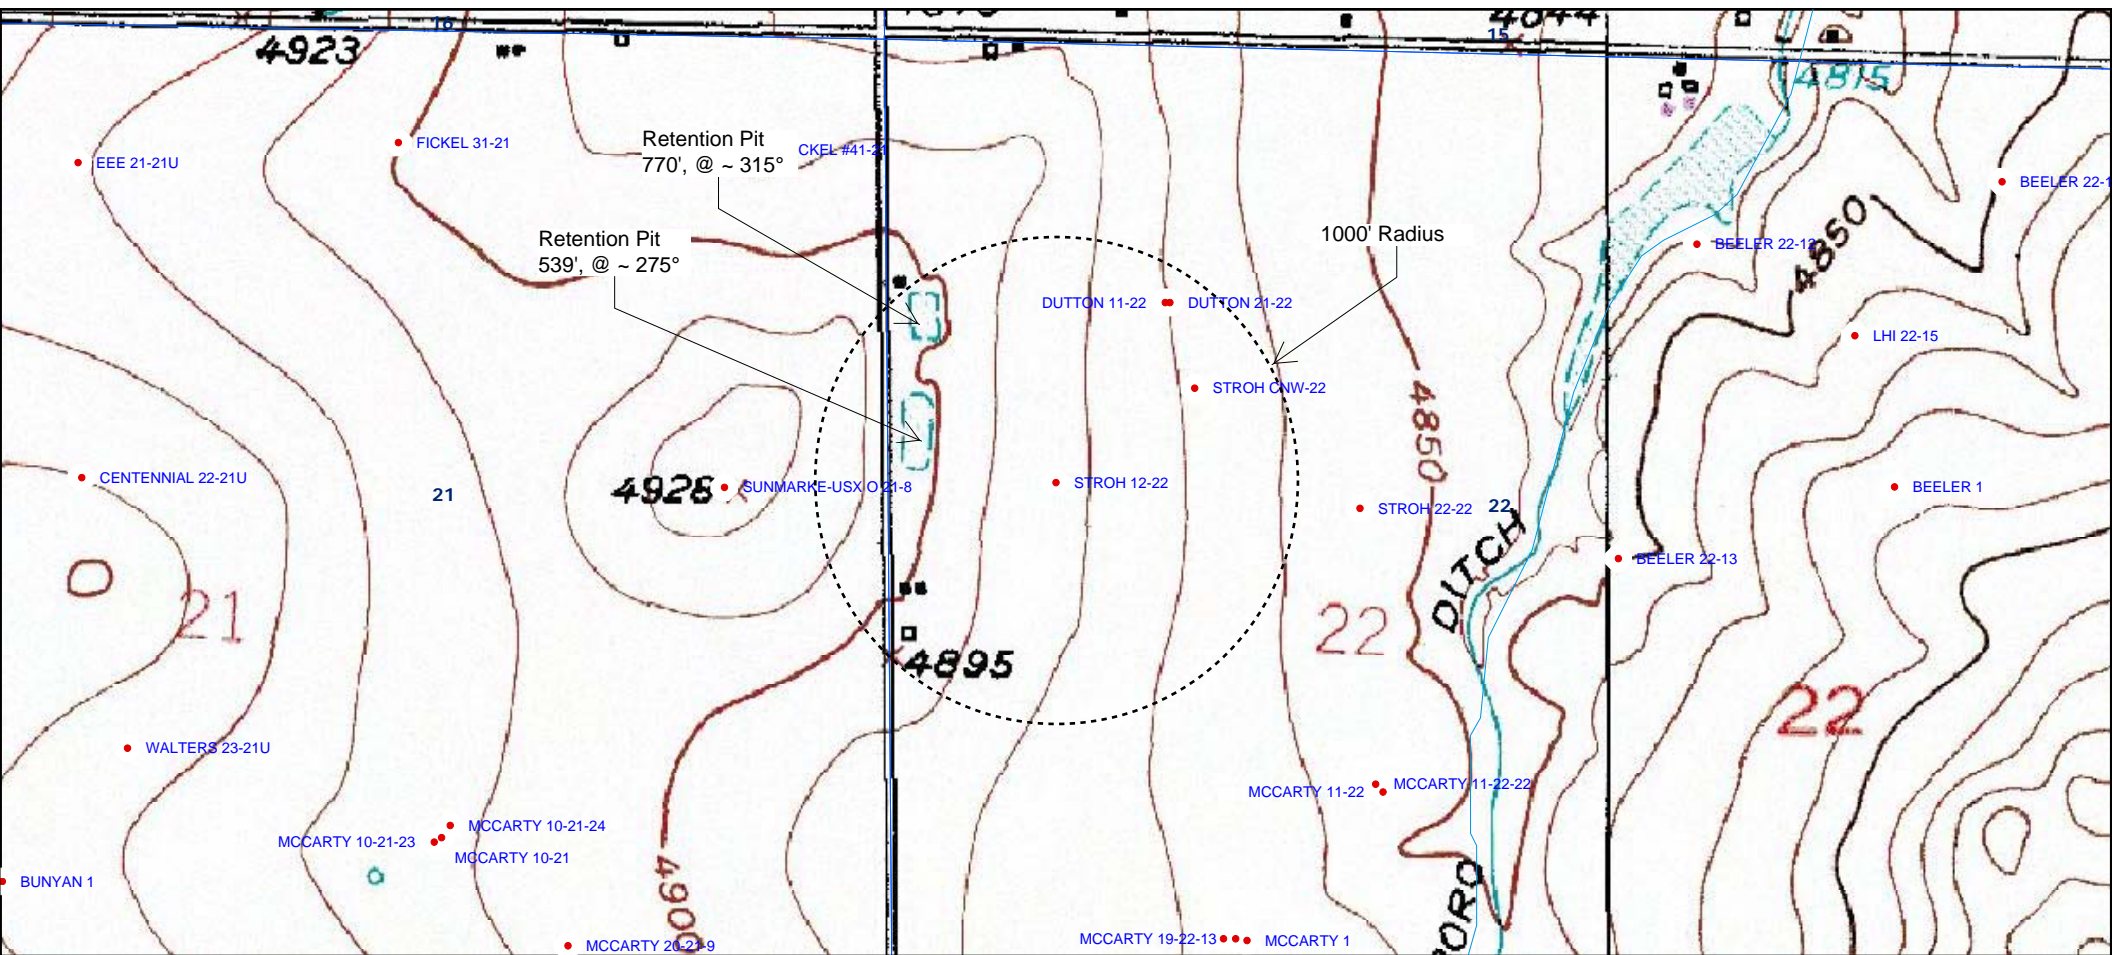

SCALE 1 : 9,614

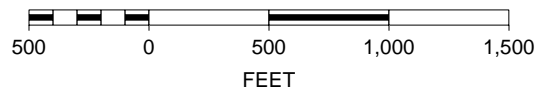

**REVIEWED**  
By Clay Duke at 11:33 am, Jan 25, 2010

Monday, January 25, 2010 11:28 AM