High Prairie Survey Co.

Physical Address: 401 Arapahoe St.
Mail to: Box 384 Kiowa, CO 80117

Ph. 303-621-8672 - Fax 303-621-2717
www.highprairiesurvey.com

Job # 09172-Hubbard 1H

Inv # 1039

High Prairie Surveying of Kiowa, Colorado has in accordance with a request from **Michael Dunn, Unit Petroleum** has determined the location of **Hubbard 1H** to be 660 feet FSL, and 660 feet FWL, (90° off Section lines) **of** SECTION **5**, Township **12s**, Range **55w** of the 6th Principal Meridian, **Lincoln County**, Colorado.

Date: Staked on 12/11/09 drawn on 12/21/09.

Re: Staked by Keith Westfall
Drawn: Drawn by Elijah Frane

Basis of Elevation Spot: USGS BM = LONG, PID = KJ0520, H-Order = Second, V-Order = Vertcon, Stability = Unknown, P-DOP = 2.3, Sats = 9 US NAD 83 CO-C, Lat. = 39.07698, Long. = W103.64826, Elevation = 5438.0 gr. (us FT).

Notes: There are no apparent improvements within 400 ft.
The ground elevation at staked location = 5265.11' gr.
7550' = TVD, 10750' = TMD, 7958' = POP
This drawing does not represent a monumented survey or Land Survey Plat.
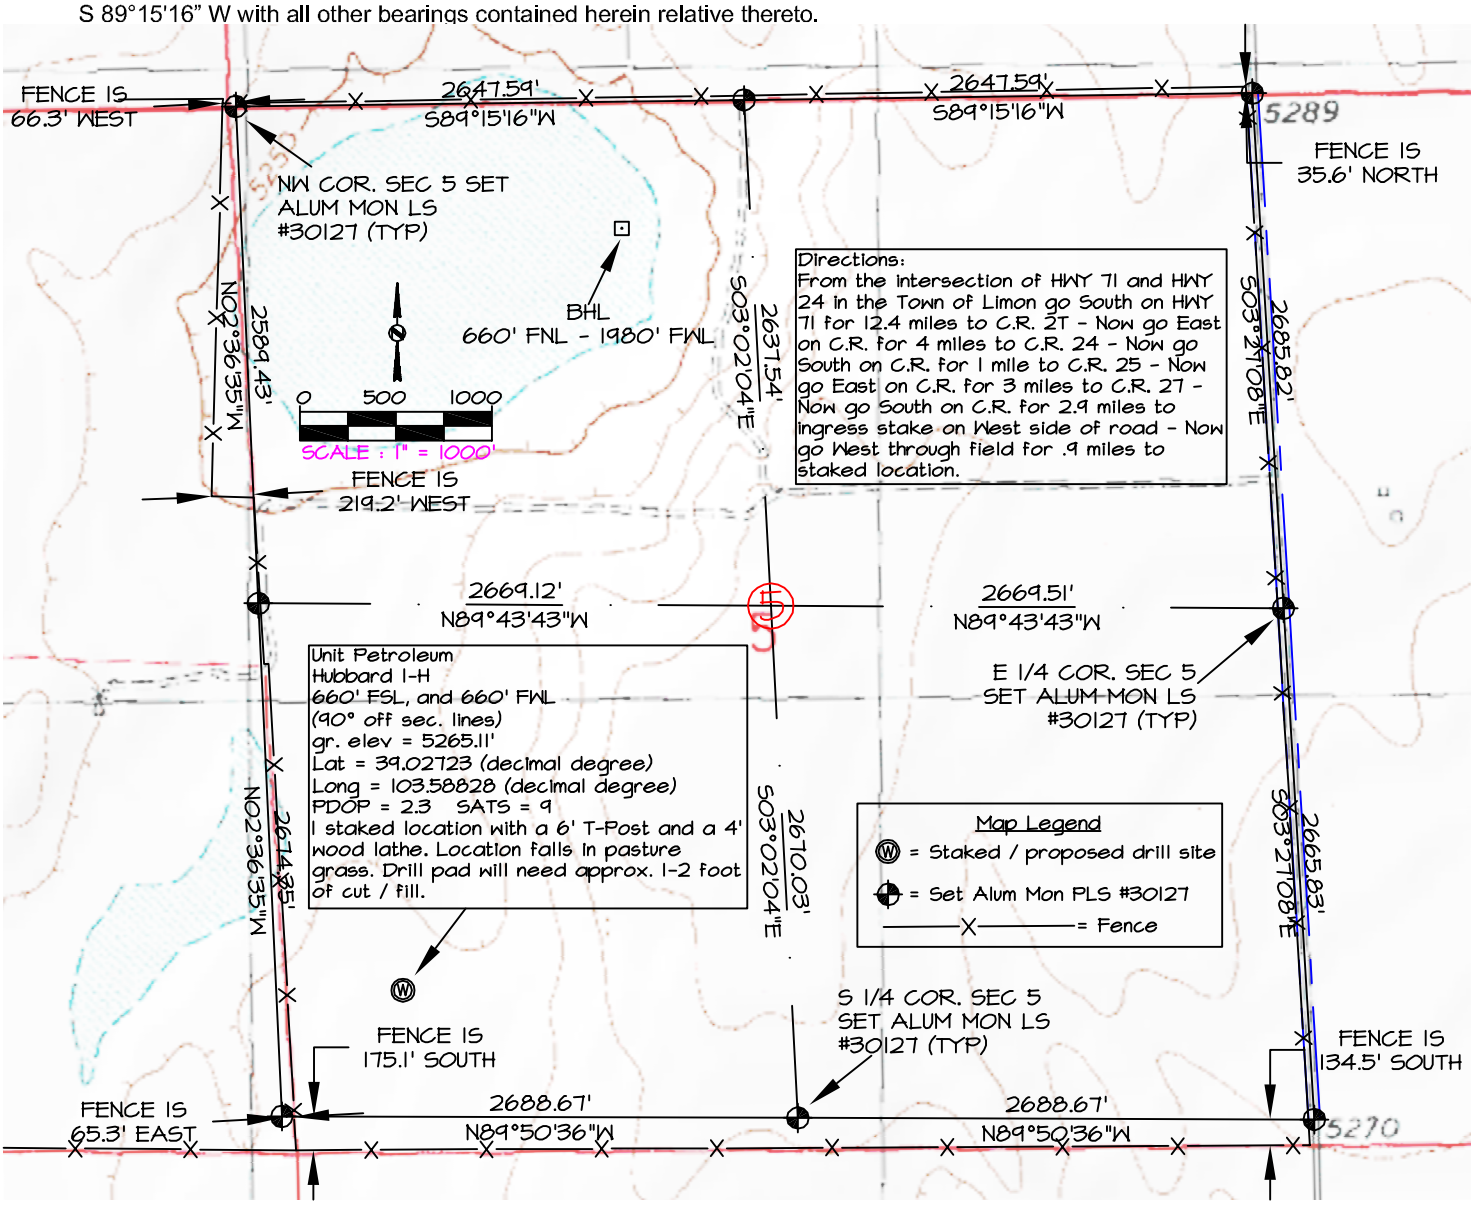
Basis of Bearing: Bearings were determined based on the North line of Section 5 to bear S 89°15'16" W with all other bearings contained herein relative thereto.