


Appendix D  
Pad Layout  
Page 1 of 4

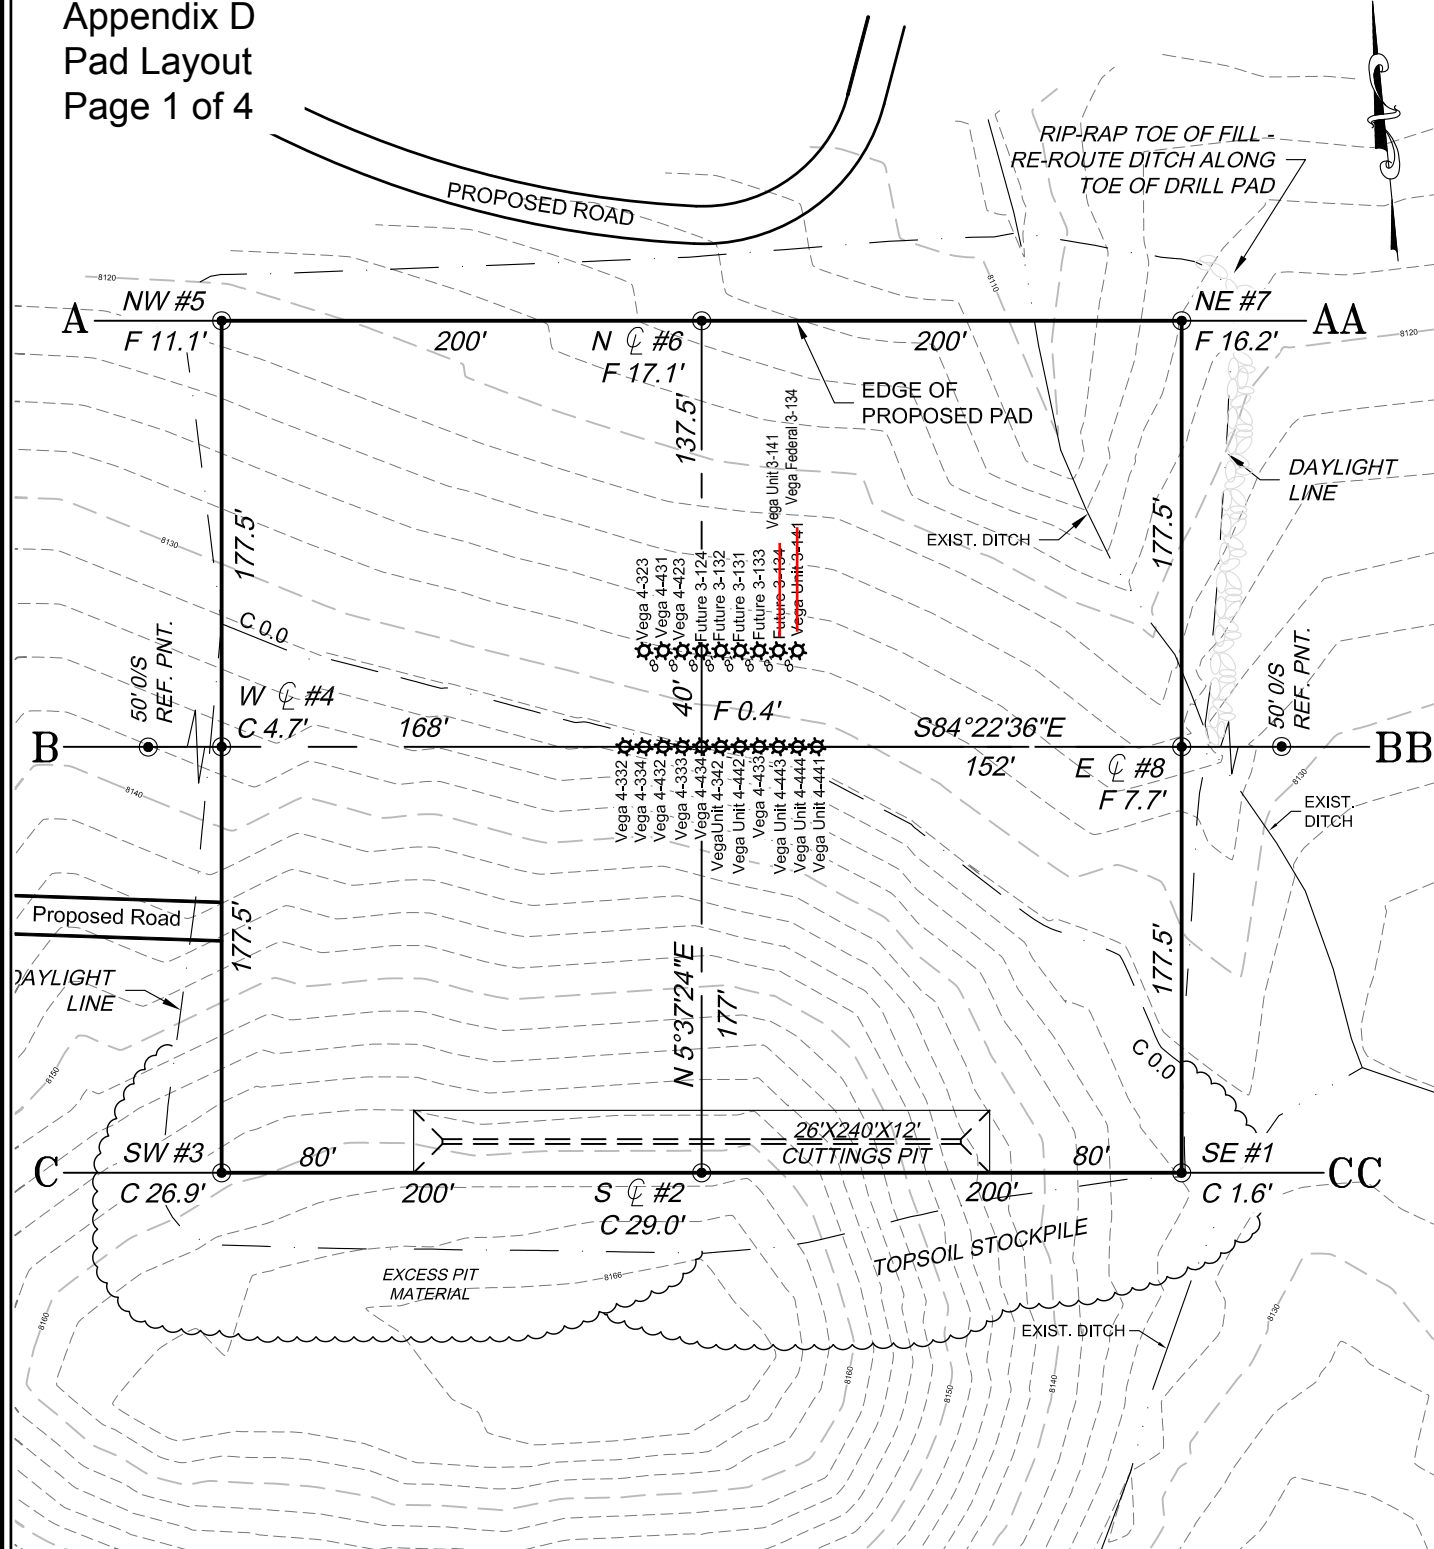

ESTIMATED DIRT QUANTITIES (cy)				
ITEM	CUT	FILL	TOPSOIL	EXCESS
PAD	36663	30059	6300	304
PIT	1440			1440
TOTALS	38103	30059	6300	1744

\*NOTE:  
1) TOPSOIL VOLUME BASED ON 12" SOIL DEPTH.  
*REVISED: 10/5/08*

Construction Plan Prepared for:  
 Delta Petroleum Corp.

Vega Unit Pad 18 - Sheet 1  
GRADING PLAN & PAD LAYOUT