Contract Surveyors, Ltd. of Denver, Colorado has in accordance with a request from Steve Woods for Bonanza Creek Energy Operating Company, LLC, determined the location of Croissant 24-3 to be 509' FSL & 1983' FWL Section 3, Township 4 North, Range 63 West of the 6th Principal Meridian, Weld County, State of Colorado. The surface elevation at this point is 4573 feet above m.s.l. A field road passes 156 feet north of the location. The Latham ditch passes 241 feet north of the location

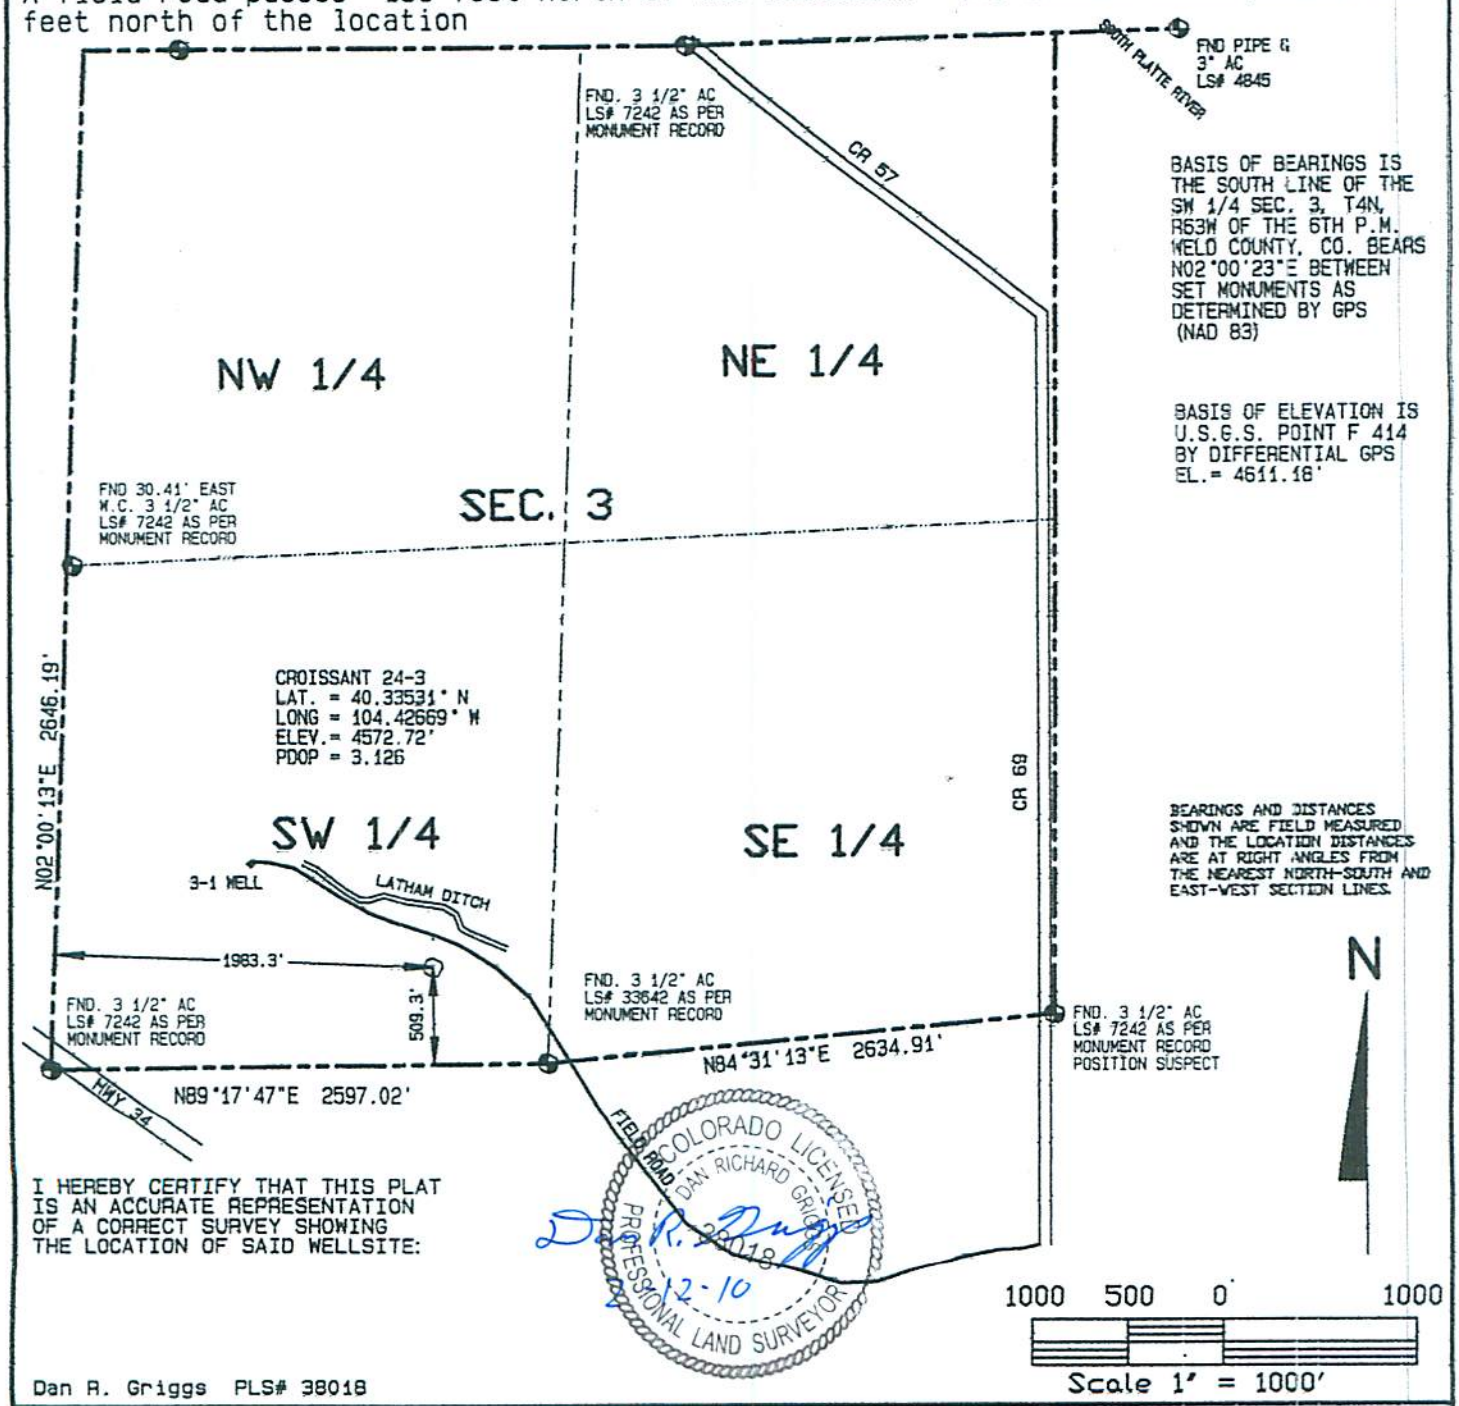

I HEREBY CERTIFY THAT THIS PLAT IS AN ACCURATE REPRESENTATION OF A CORRECT SURVEY SHOWING THE LOCATION OF SAID WELLSITE:

Dan R. Griggs 12-10-2018

Dan R. Griggs PLS# 38018

CONTRACT SURVEYORS, LTD. COMPLETE SURVEYING AND GLOBAL POSITIONING 2133 SOUTH BELLAIRE STREET #14 DENVER COLORADO 80222 (303) 756-3695	DATE OF FIELD WORK 11 FEBRUARY, 2010	DATE OF DRAWING 12 FEBRUARY 2010
	CROISSANT 24-3	
	SE 1/4, SW 1/4 SEC. 3, T4N, R63W	
	BONANAZA CREEK ENERGY OPERATING COMPANY, LLC	
CSL# 10104-03	WELD COUNTY, COLORADO	