


The accompanying plat is an accurate representation showing the location of a proposed well. This location may be described as a point 465 feet South of the North line, and 1161 feet East of the West line of Section 11, Township 1 North, Range 47 West of the 6th P.M., Yuma County, Colorado.

The surface elevation at this point is 4027 feet m.s.l.

Note: This is not a land survey plat.

There are no visible improvements within 400 feet of the location, except an existing center pivot irrigation system.

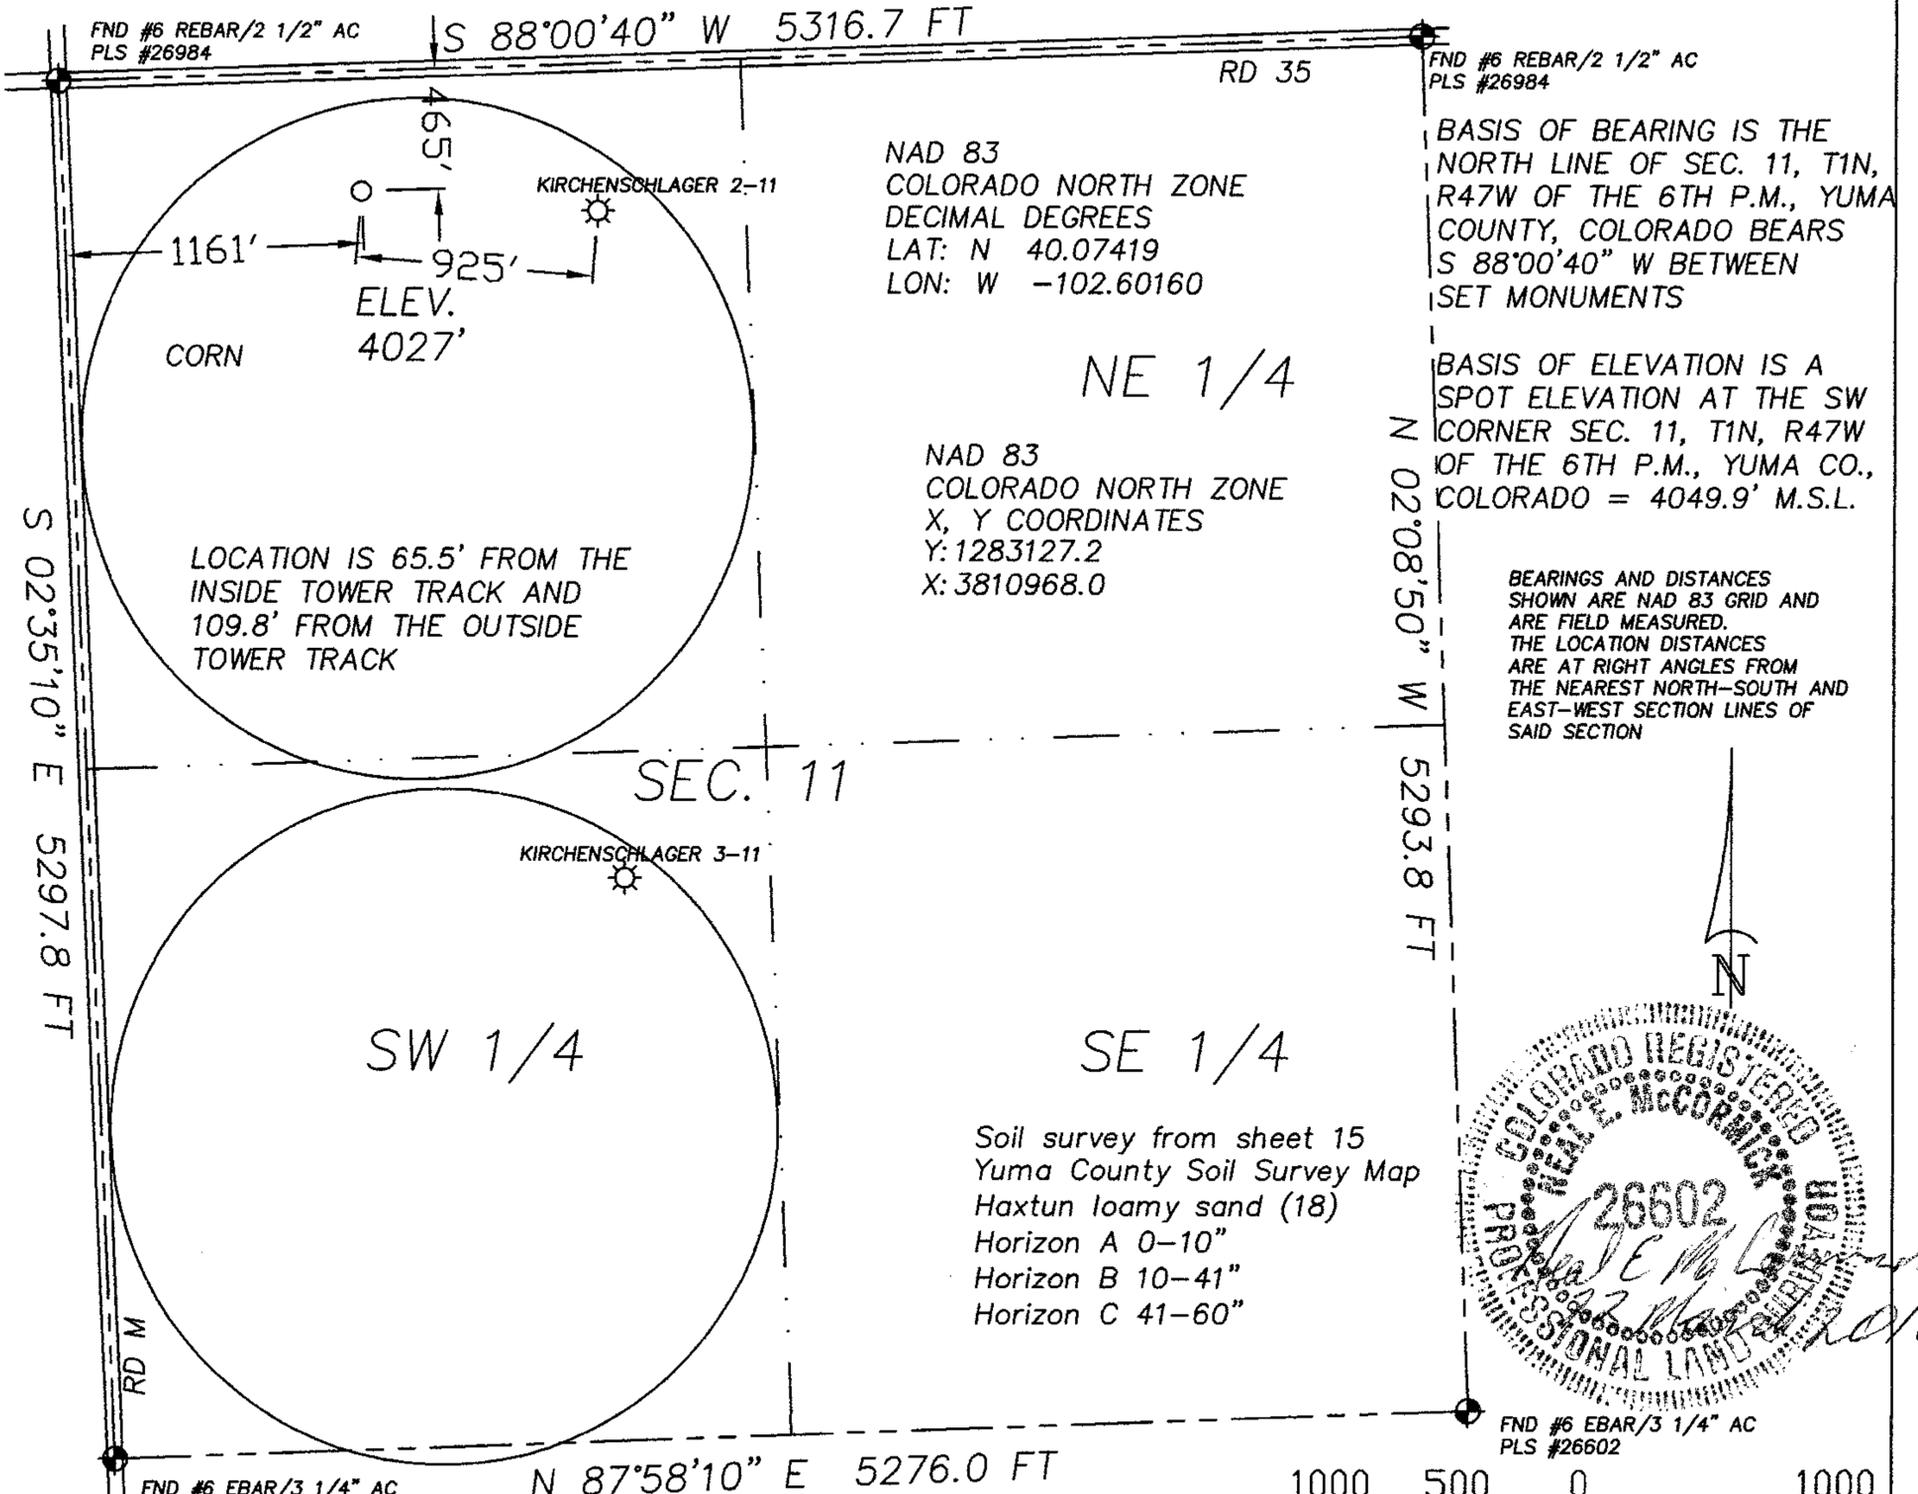


BASIS OF BEARING IS THE NORTH LINE OF SEC. 11, T1N, R47W OF THE 6TH P.M., YUMA COUNTY, COLORADO BEARS S 88°00'40" W BETWEEN SET MONUMENTS


BASIS OF ELEVATION IS A SPOT ELEVATION AT THE SW CORNER SEC. 11, T1N, R47W OF THE 6TH P.M., YUMA CO., COLORADO = 4049.9' M.S.L.

BEARINGS AND DISTANCES SHOWN ARE NAD 83 GRID AND ARE FIELD MEASURED. THE LOCATION DISTANCES ARE AT RIGHT ANGLES FROM THE NEAREST NORTH-SOUTH AND EAST-WEST SECTION LINES OF SAID SECTION

Soil survey from sheet 15
 Yuma County Soil Survey Map
 Haxtun loamy sand (18)
 Horizon A 0-10"
 Horizon B 10-41"
 Horizon C 41-60"

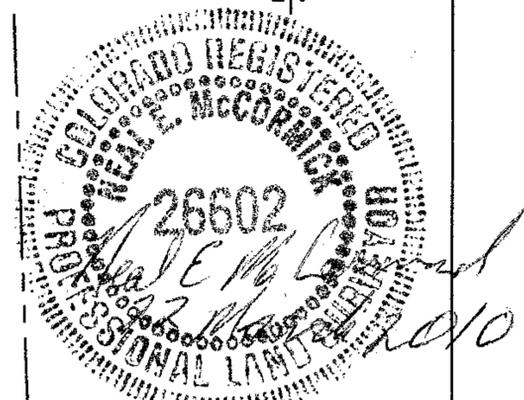

- 2.78 PDOP
- ☀ Dual Producer
- Oil well
- ☼ Gas Well
- Dry Hole
- GPS OPERATOR: NEAL MCCORMICK
- Location
- Fence Line
- Half-Sec. Line
- Section Line
- ==== Road
- == Trail
- ◆ Survey Monument

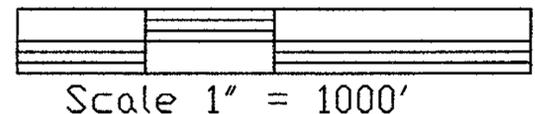

GREAT PLAINS SURVEYING, INC.

20575 Co. Rd. 21 Phone 970-774-3602
 Haxtun, CO 80731 Fax 970-774-3601

DATE OF FIELD WORK: 18 MARCH 2010	DATE OF DRAWING: 22 MARCH 2010
KIRCHENSCHLAGER 11-11 1N47W	
NW 1/4 NW 1/4 SEC. 11, T1N, R47W	
AUGUSTUS ENERGY PARTNERS, LLC.	
YUMA COUNTY, COLORADO	