


WELL LOCATION CERTIFICATE

THIS MAP DOES NOT REPRESENT A BOUNDARY SURVEY

County Road 20

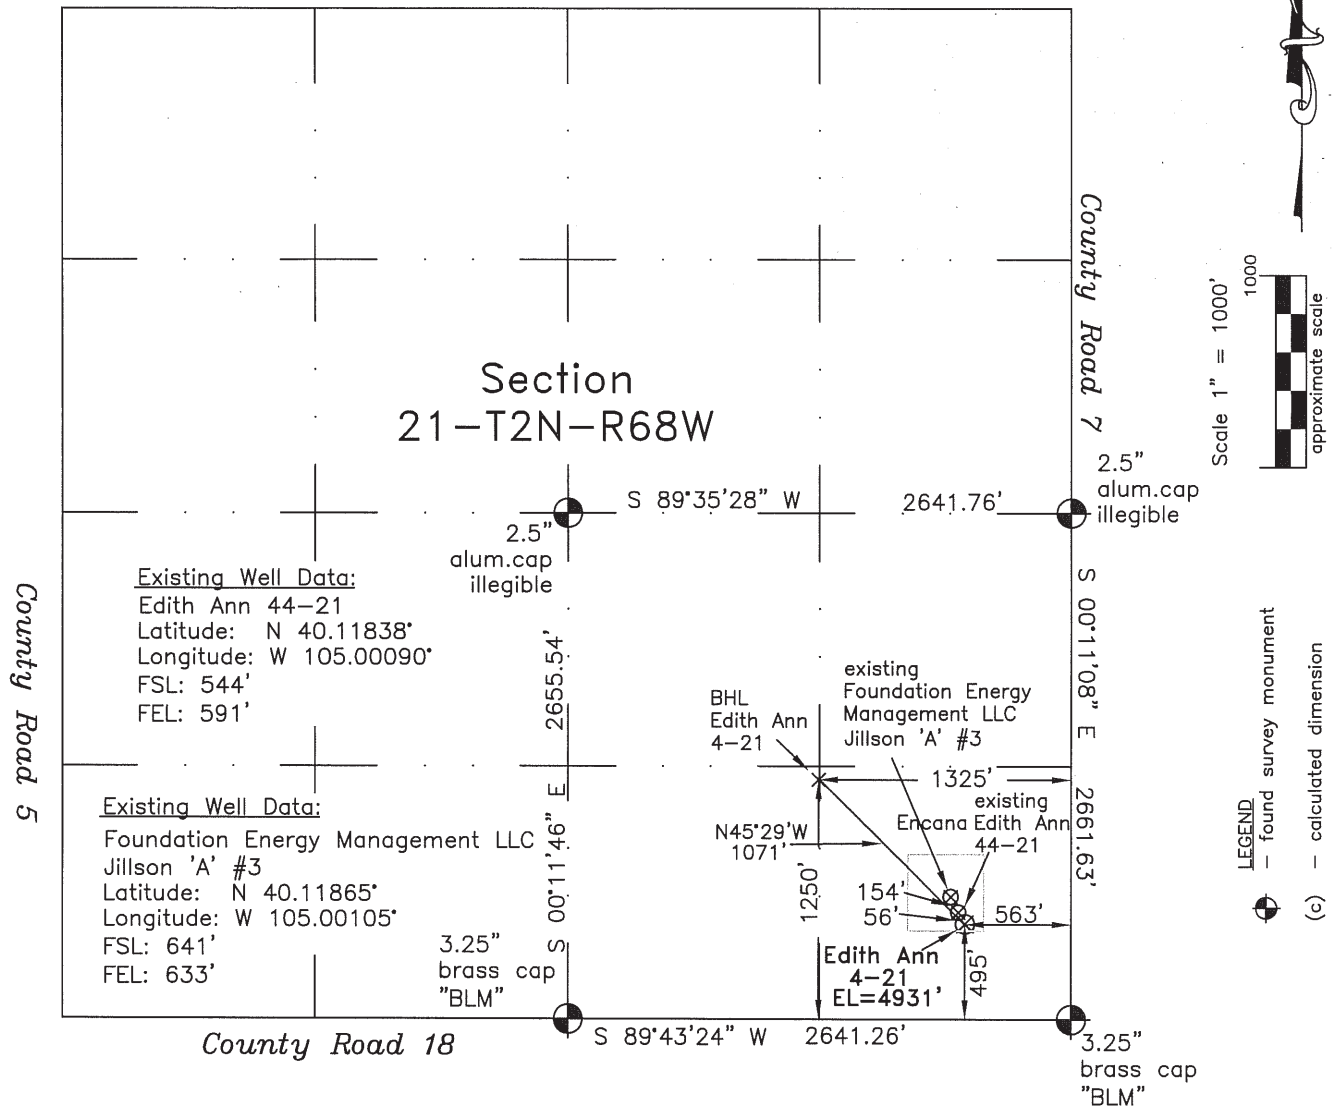

In accordance with a request from Doug Pearlman of EnCana Oil & Gas (USA) Inc., Frederick Land Surveying, Inc. has determined the location of the **Edith Ann 4-21** well site to be SHL: 495' FSL and 563' FEL, (BHL 1250' FSL and 1325' FEL), as measured at ninety (90) degrees from the section lines of Section 21, Township 2 North, Range 68 West of the 6th Principal Meridian, Weld County Colorado.

Proposed Surface Hole Data:

Latitude: N 40.11825° BHL(40.12032°)

Longitude: W 105.00080° BHL(105.00351°)

Nearest: Building 177' southwest

Above Ground Utility 525' south

Public Road 483' south

Railroad 19,700' south

Property Line 495' south

PDOP: 3.4

Notes:

- 1) Bearings and distances based on NAD 83 Colorado North State Plane Coordinates using RTK GPS observations taken 2/26/10 by operator Tom Winans.
- 2) Conversion factor to ground (1.000274028).
- 3) Elevations based on NAVD 88 GPS heights and Geoid 2003 corrections.
- 4) See improvement map for visible improvements within 400 feet of pad site.
- 5) The location falls on agricultural land.

NOTICE: According to Colorado law you must commence any legal action based upon any defect in this W.L.C. within three years after you first discover such defect. In no event may any action based upon any defect in this W.L.C. be commenced more than ten years from this said date of the certification shown hereon.

I hereby certify that this Well Location Certificate was prepared by me or under my direct supervision on 2/26/10 for and on behalf of EnCana Oil & Gas (USA) Inc. and that it is not a Land Survey Plat and that it is not to be relied upon for establishment of fences, buildings, or other future improvement lines.

Alex Ronald Perkins #34176
 Job #: 09104.004 3-A-2010