

WELL LOCATION CERTIFICATE: EVERIST 40-32

SECTION 32, TOWNSHIP 3 NORTH, RANGE 67 WEST, 6TH P.M.

NW SEC. 32
2" ALUM. CAP
LS 23500

S 89°55'29" E 2642.67'

S 89°55'43" E 2642.95'

NE SEC. 32
2½" ALUM. CAP
LS 19585

N ¼ SEC. 32
2½" ALUM. CAP
LS 19585

NOTES:

THIS IS A DIRECTIONAL WELL
BH LOCATION TO BE 2580' FSL & 50' FEL
BH LOCATION PROVIDED BY CLIENT.
LAND SURFACE USE-GRASS HAY
TWINNING PROPOSED WELL EVERIST 28-5
TO BE 16' W
PROPOSED WELL EVERIST 28-5 TO BE
2189' FSL & 1607' FEL
EXISTING WELL HSR-NELSON 10-32 IS 198' W
SEE ATTACHED MAP FOR ADDITIONAL
IMPROVEMENTS WITHIN 400'.

N 00°19'53" W 2649.16'

S 00°35'11" E 2656.71'

W ¼ SEC. 32
2½" ALUM. CAP
LS 24670

32

BH- 2580' FSL
50' FEL

E ¼ SEC. 32
2½" ALUM. CAP
LS 23501

SURFACE LOCATION
GROUND ELEVATION= 4803'
NAD83
LATITUDE= 40.181191°
LONGITUDE= 104.910043°

BOTTOM HOLE LOCATION
NAD83
LATITUDE= 40.182214°
LONGITUDE= 104.904529°

PDOP= 1.73
GPS OPERATOR: CHRIS PEARSON

(BASIS OF BEARINGS) SEE NOTE 3
N 00°20'36" W 2616.47'

HSR-NELSON
10-32

EVERIST 28-5

EVERIST
40-32

N 76°01'38" E
1586'
1591'

2189'

S 00°24'18" E 2630.67'

SW SEC. 32
2" ALUM. CAP
LS 20676

N 89°41'24" W 2670.02'


N 89°41'46" W 2630.46'

SE SEC. 32
2½" ALUM. CAP
LS 23501

WELL **EVERIST 40-32** TO BE LOCATED 2189' FSL AND 1591' FEL, SECTION 32, T3N, R67W OF THE 6th P.M.

LEGEND

- ⊕ = EXISTING MONUMENT
- ⊙ = PROPOSED WELL
- ⬥ = BOTTOM HOLE
- ◆ = EXISTING WELL
- BH = BOTTOM HOLE

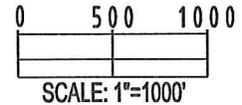

I, JERRY F. HARCEK, JR., A LICENSED PROFESSIONAL LAND SURVEYOR IN THE STATE OF COLORADO DO HEREBY CERTIFY TO **KERR-MCGEE OIL & GAS ONSHORE LP**, THAT THE SURVEY AND WELL LOCATION CERTIFICATE SHOWN HEREON WERE DONE BY ME OR UNDER MY DIRECT SUPERVISION AND THAT THE DRAWING SHOWN HEREON ACCURATELY DEPICTS THE PROPOSED LOCATION OF THE WELL **EVERIST 40-32**. THIS CERTIFICATE DOES NOT REPRESENT A LAND SURVEY PLAT OR IMPROVEMENT SURVEY PLAT AS DEFINED BY C.R.S. 38-51-102 AND CANNOT BE RELIED UPON TO DETERMINE OWNERSHIP.

JERRY F. HARCEK, JR., PLS 34997
COLORADO LICENSED PROFESSIONAL LAND SURVEYOR
FOR AND ON BEHALF OF P.F.S., LLC



NOTES:


1. THIS SURVEY WAS DONE BY GPS METHODS AND CONFORMS TO THE MINIMUM STANDARDS SET BY THE C.O.G.C.C., RULE NO. 215
2. ELEVATIONS SHOWN AT THE WELL HEAD, AS WELL AS HORIZONTAL CONTROL, ARE BASED ON GPS-RTK VALUES DERIVED FROM DOING 2-HOUR STATIC GPS SESSIONS AND REDUCTIONS USING O.P.U.S. SOLUTIONS.
VERTICAL = NAVD88; HORIZONTAL = NAD83/92
3. THE BEARINGS SHOWN HEREON ARE BASED ON GPS OBSERVATIONS BETWEEN THE MONUMENTS SHOWN HEREON AS FOUND ON THE FIELD DATE BELOW.
4. DISTANCES SHOWN ARE AT GROUND LEVEL, AS MEASURED IN THE FIELD, WITH TIES TO WELLS MEASURED AT A PERPENDICULAR TO SECTION LINES.

NOTICE: ACCORDING TO COLORADO LAW YOU MUST COMMENCE ANY LEGAL ACTION BASED UPON ANY DEFECT IN THIS SURVEY WITHIN THREE YEARS AFTER YOU FIRST DISCOVER SUCH DEFECT. IN NO EVENT MAY ANY ACTION BASED UPON ANY DEFECT IN THIS SURVEY BE COMMENCED MORE THAN TEN YEARS FROM THIS SAID DATE OF THIS CERTIFICATION SHOWN HEREON.

PREPARED BY: PFS Petroleum Field Services, LLC 1801 W. 13th Ave. Denver, CO 80204	FIELD DATE: 10-06-09	WELL NAME: EVERIST 40-32
	DRAWING DATE: 03-02-10	SURFACE LOCATION: WELD COUNTY, COLORADO
	BY: SMF	NW 1/4 SE 1/4, SEC. 32, T3N, R67W

EXHIBIT: NAD27 CONVERSION

SECTION 32, TOWNSHIP 3 NORTH, RANGE 67 WEST, 6TH P.M.

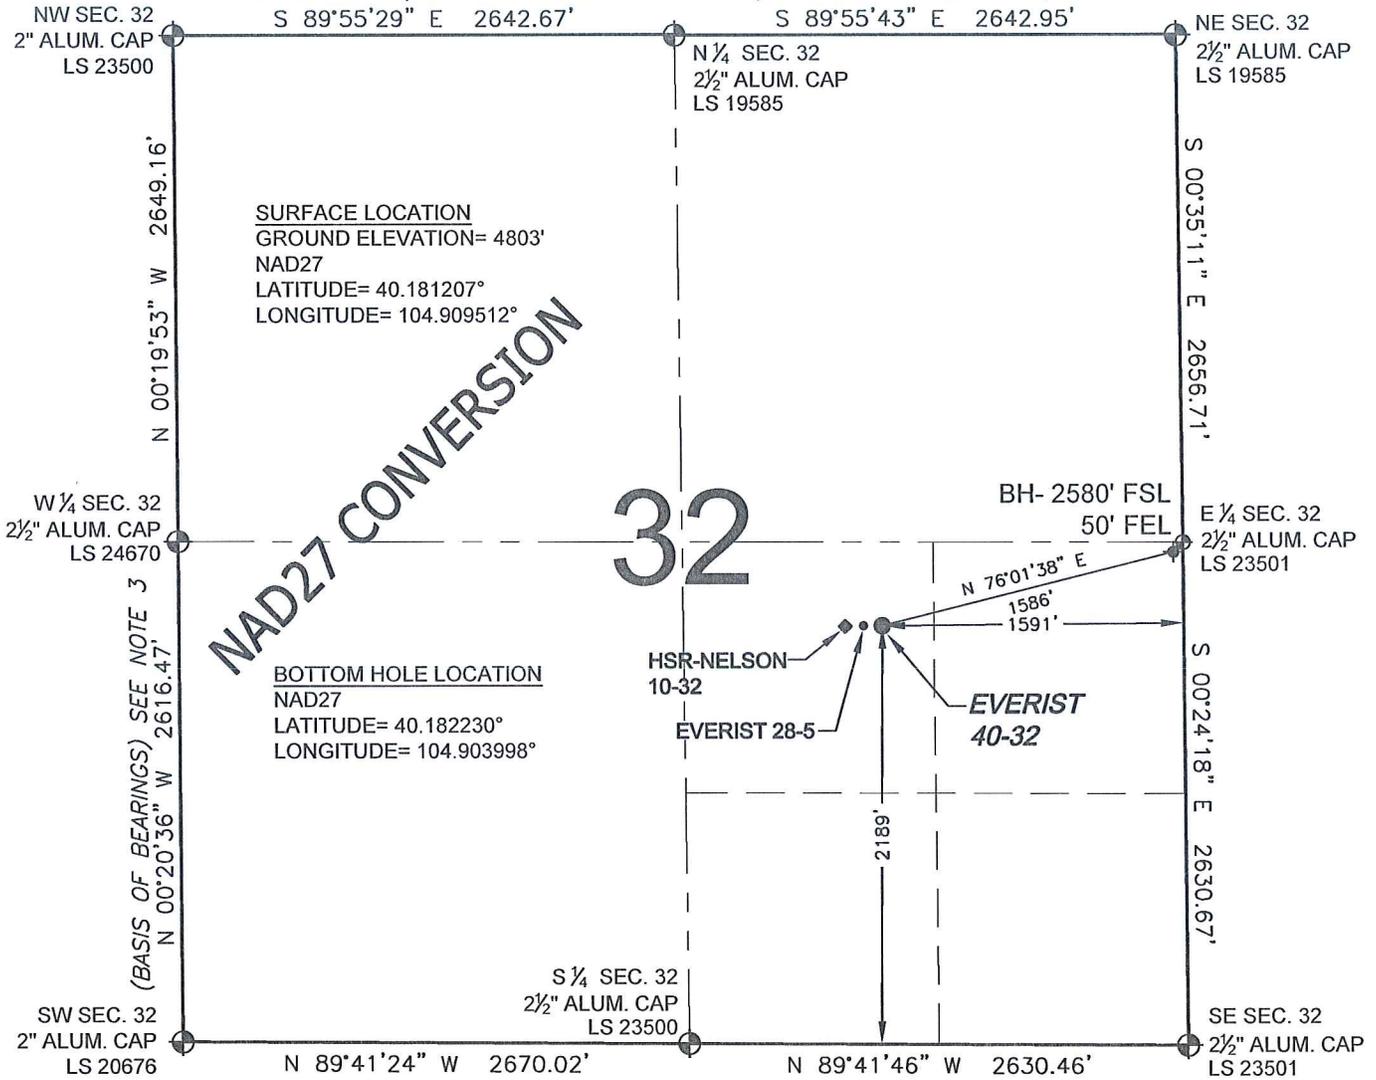

WELL **EVERIST 40-32** TO BE LOCATED 2189' FSL AND 1591' FEL, SECTION 32, T3N, R67W OF THE 6th P.M.


NOTES:

1. THIS SURVEY WAS DONE BY GPS METHODS AND CONFORMS TO THE MINIMUM STANDARDS SET BY THE C.O.G.C.C., RULE NO. 215
2. ELEVATIONS SHOWN AT THE WELL HEAD, AS WELL AS HORIZONTAL CONTROL, ARE BASED ON GPS-RTK VALUES DERIVED FROM DOING 2-HOUR STATIC GPS SESSIONS AND REDUCTIONS USING O.P.U.S. SOLUTIONS.
VERTICAL = NAVD88; HORIZONTAL = NAD83/92
3. THE BEARINGS SHOWN HEREON ARE BASED ON GPS OBSERVATIONS BETWEEN THE MONUMENTS SHOWN HEREON AS FOUND ON THE FIELD DATE BELOW.
4. DISTANCES SHOWN ARE AT GROUND LEVEL, AS MEASURED IN THE FIELD, WITH TIES TO WELLS MEASURED AT A PERPENDICULAR TO SECTION LINES.

LEGEND

- ⊕ = EXISTING MONUMENT ⊕ = BOTTOM HOLE BH = BOTTOM HOLE
- = PROPOSED WELL ◆ = EXISTING WELL

NOTE: LATITUDE AND LONGITUDE SHOWN WERE CONVERTED FROM NAD83 USING CORPSCON 6.0 (PROGRAM). PFS DOES NOT WARRANT OR GUARANTEE THEIR ACCURACY.

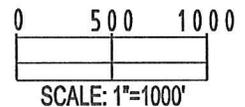

PREPARED BY:  Petroleum Field Services, LLC 1801 W. 13th Ave Denver, CO 80204	FIELD DATE: 10-06-09	WELL NAME: EVERIST 40-32
	DRAWING DATE: 03-02-10	SURFACE LOCATION: WELD COUNTY, COLORADO
	BY: SMF	NW 1/4 SE 1/4, SEC. 32, T3N, R67W

NOTICE: ACCORDING TO COLORADO LAW YOU MUST COMMENCE ANY LEGAL ACTION BASED UPON ANY DEFECT IN THIS SURVEY WITHIN THREE YEARS AFTER YOU FIRST DISCOVER SUCH DEFECT. IN NO EVENT MAY ANY ACTION BASED UPON ANY DEFECT IN THIS SURVEY BE COMMENCED MORE THAN TEN YEARS FROM THIS SAID DATE OF THIS CERTIFICATION SHOWN HEREON.