



March 19, 2010

Department of Natural Resources  
Oil and Gas Conservation Commission  
The Chancery Building  
1120 Lincoln St., Suite 801  
Denver, CO 80203

Re: **20 Day Certification Letter - 318A-e**  
EVERIST 40-32  
Township 3 North, Range 67 West, Section 32: NW/4SE/4  
Unit Spacing: 03N-67W-32 SE/4NE/4 NE/4SE/4  
03N-67W-33 SW/4NW/4 NW/4SW/4  
Weld County, Colorado

Ladies/Gentlemen:

Kerr-McGee Oil and Gas Onshore LP ("KMG") hereby certifies to the Director that a twenty (20) day notice has been given by certified mail to all owners in the proposed wellbore spacing unit. We have not received any objections to such well location, proposed spacing unit, or additional producing formation. KMG hereby requests the Director to approve the boundary well.

If you have any questions or issues regarding this permit, please contact Cheryl Light at (720) 929-6461.

Very truly yours,

**Kerr-McGee Oil and Gas Onshore LP**

A handwritten signature in blue ink that reads 'Rebecca Heim'.

**Rebecca Heim**  
**Regulatory Analyst II**

:cl  
Enclosure

318A Proposed Spacing  
Unit Plan

# WELL LOCATION CERTIFICATE: EVERIST 40-32

SECTION 32, TOWNSHIP 3 NORTH, RANGE 67 WEST, 6TH P.M.

NW SEC. 32 2" ALUM. CAP LS 23500 S 89°55'29" E 2642.67' N 00°19'53" W 2649.16' N 1/4 SEC. 32 2 1/2" ALUM. CAP LS 19585 S 89°55'43" E 2642.95' NE SEC. 32 2 1/2" ALUM. CAP LS 19585

**NOTES:**  
THIS IS A DIRECTIONAL WELL  
BH LOCATION TO BE 2580' FSL & 50' FEL  
BH LOCATION PROVIDED BY CLIENT.  
LAND SURFACE USE-GRASS HAY  
TWINNING PROPOSED WELL EVERIST 28-5 TO BE 16' W  
PROPOSED WELL EVERIST 28-5 TO BE 2189' FSL & 1607' FEL  
EXISTING WELL HSR-NELSON 10-32 IS 198' W  
SEE ATTACHED MAP FOR ADDITIONAL IMPROVEMENTS WITHIN 400'.

**SURFACE LOCATION**  
GROUND ELEVATION= 4803'  
NAD83  
LATITUDE= 40.181191°  
LONGITUDE= 104.910043°

**BOTTOM HOLE LOCATION**  
NAD83  
LATITUDE= 40.182214°  
LONGITUDE= 104.904529°

PDOP= 1.73  
GPS OPERATOR: CHRIS PEARSON

# 32

HSR-NELSON 10-32

EVERIST 28-5

BH- 2580' FSL  
50' FEL

N 76°01'38" E  
1586'  
1591'

EVERIST 40-32

16812

W 1/4 SEC. 32 2 1/2" ALUM. CAP LS 24670

(BASIS OF BEARINGS) SEE NOTE 3  
N 00°20'36" W 2616.47'

SW SEC. 32 2" ALUM. CAP LS 20676

N 89°41'24" W 2670.02'

S 1/4 SEC. 32 2 1/2" ALUM. CAP LS 23500


N 89°41'46" W 2630.46'

SE SEC. 32 2 1/2" ALUM. CAP LS 23501

WELL EVERIST 40-32 TO BE LOCATED 2189' FSL AND 1591' FEL, SECTION 32, T3N, R67W OF THE 6th P.M.

**LEGEND**

- ⊕ = EXISTING MONUMENT
- ⊙ = PROPOSED WELL
- ⊕ = BOTTOM HOLE
- ⊙ = EXISTING WELL
- BH = BOTTOM HOLE

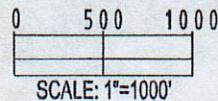

**NOTES:**

1. THIS SURVEY WAS DONE BY GPS METHODS AND CONFORMS TO THE MINIMUM STANDARDS SET BY THE C.O.G.C.C., RULE NO. 215
2. ELEVATIONS SHOWN AT THE WELL HEAD, AS WELL AS HORIZONTAL CONTROL, ARE BASED ON GPS-RTK VALUES DERIVED FROM DOING 2-HOUR STATIC GPS SESSIONS AND REDUCTIONS USING O.P.U.S. SOLUTIONS.  
VERTICAL = NAVD88; HORIZONTAL = NAD83/92
3. THE BEARINGS SHOWN HEREON ARE BASED ON GPS OBSERVATIONS BETWEEN THE MONUMENTS SHOWN HEREON AS FOUND ON THE FIELD DATE BELOW.
4. DISTANCES SHOWN ARE AT GROUND LEVEL, AS MEASURED IN THE FIELD, WITH TIES TO WELLS MEASURED AT A PERPENDICULAR TO SECTION LINES.

I, JERRY F. HARCEK, JR., A LICENSED PROFESSIONAL LAND SURVEYOR IN THE STATE OF COLORADO DO HEREBY CERTIFY TO KERR-MCGEE OIL & GAS ONSHORE LP, THAT THE SURVEY AND WELL LOCATION CERTIFICATE SHOWN HEREON WERE DONE BY ME OR UNDER MY DIRECT SUPERVISION AND THAT THE DRAWING SHOWN HEREON ACCURATELY DEPICTS THE PROPOSED LOCATION OF THE WELL EVERIST 40-32. THIS CERTIFICATE DOES NOT REPRESENT A LAND SURVEY PLAT OR IMPROVEMENT SURVEY PLAT AS DEFINED BY C.R.S. 38-51-102 AND CANNOT BE RELIED UPON TO DETERMINE OWNERSHIP.




JERRY F. HARCEK, JR., PLS 34997  
COLORADO LICENSED PROFESSIONAL LAND SURVEYOR  
FOR AND ON BEHALF OF P.F.S., LLC

PREPARED BY: <b>PFS</b> Petroleum Field Services, LLC 1801 W. 13th Ave. Denver, CO 80204	FIELD DATE: 10-06-09	WELL NAME: EVERIST 40-32
	DRAWING DATE: 03-02-10	SURFACE LOCATION: WELD COUNTY, COLORADO
	BY: SMF	NW 1/4 SE 1/4, SEC. 32, T3N, R67W

NOTICE: ACCORDING TO COLORADO LAW YOU MUST COMMENCE ANY LEGAL ACTION BASED UPON ANY DEFECT IN THIS SURVEY WITHIN THREE YEARS AFTER YOU FIRST DISCOVER SUCH DEFECT. IN NO EVENT MAY ANY ACTION BASED UPON ANY DEFECT IN THIS SURVEY BE COMMENCED MORE THAN TEN YEARS FROM THIS SAID DATE OF THIS CERTIFICATION SHOWN HEREON.

**EVERIST 40-32**  
**NWSE Sec. 32 T3N-R67W**

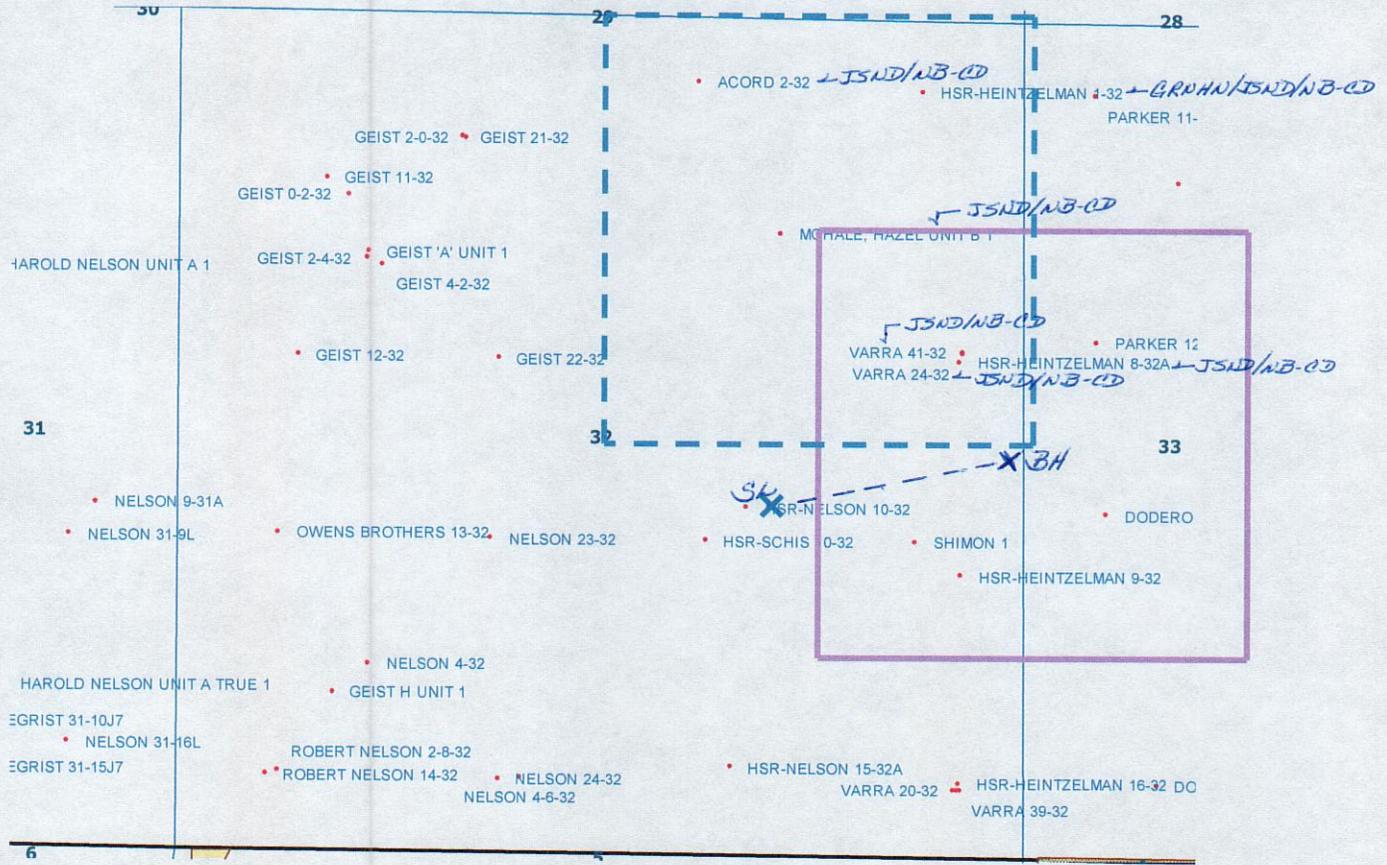

**LEGEND**



Proposed 160 acre Spacing Unit (Solid line).



Bottom Hole Located NE/4SE/4, Sec. 32-T3N-R67W (Dashed line).

**This 1/4 Section has less than 8 bottom hole wells producing from the Codell, Niobrara & J Sand Formations.**