


TOPO! map printed on 11/17/09 from "Untitled.tpo"

102.31667° W

WGS84 102.30000° W

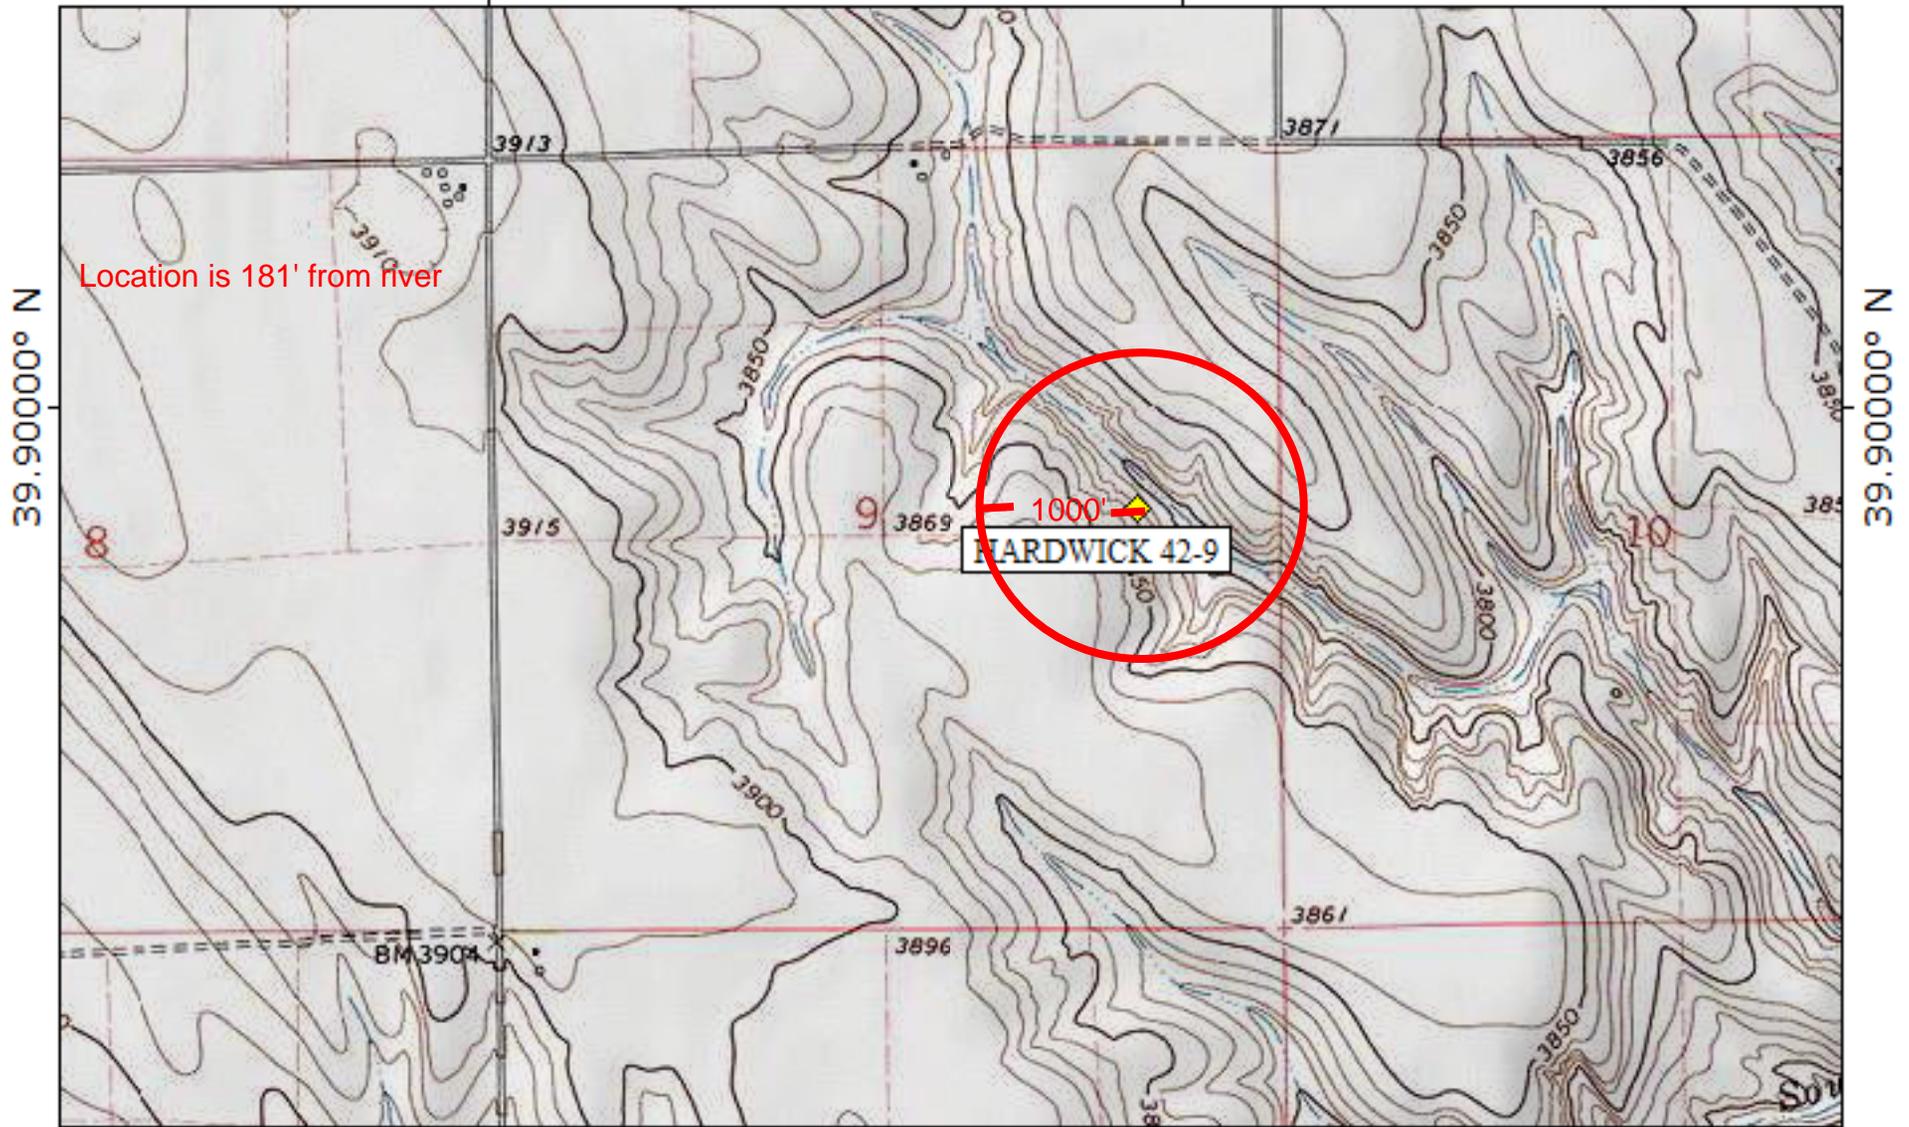


39.90000° N

39.90000° N

102.31667° W

WGS84 102.30000° W

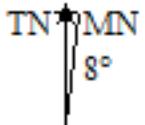

Map created with TOPO!® ©2003 National Geographic (www.nationalgeographic.com/topo)