


# T11S, R90W, 6th P.M.

1922 Brass Cap  
1.2' High  
Lat: 39.092700°  
Long: 107.480372°

1922 Brass Cap  
1.2' High, Pile of  
Stones  
Lat: 39.092717°  
Long: 107.471053°

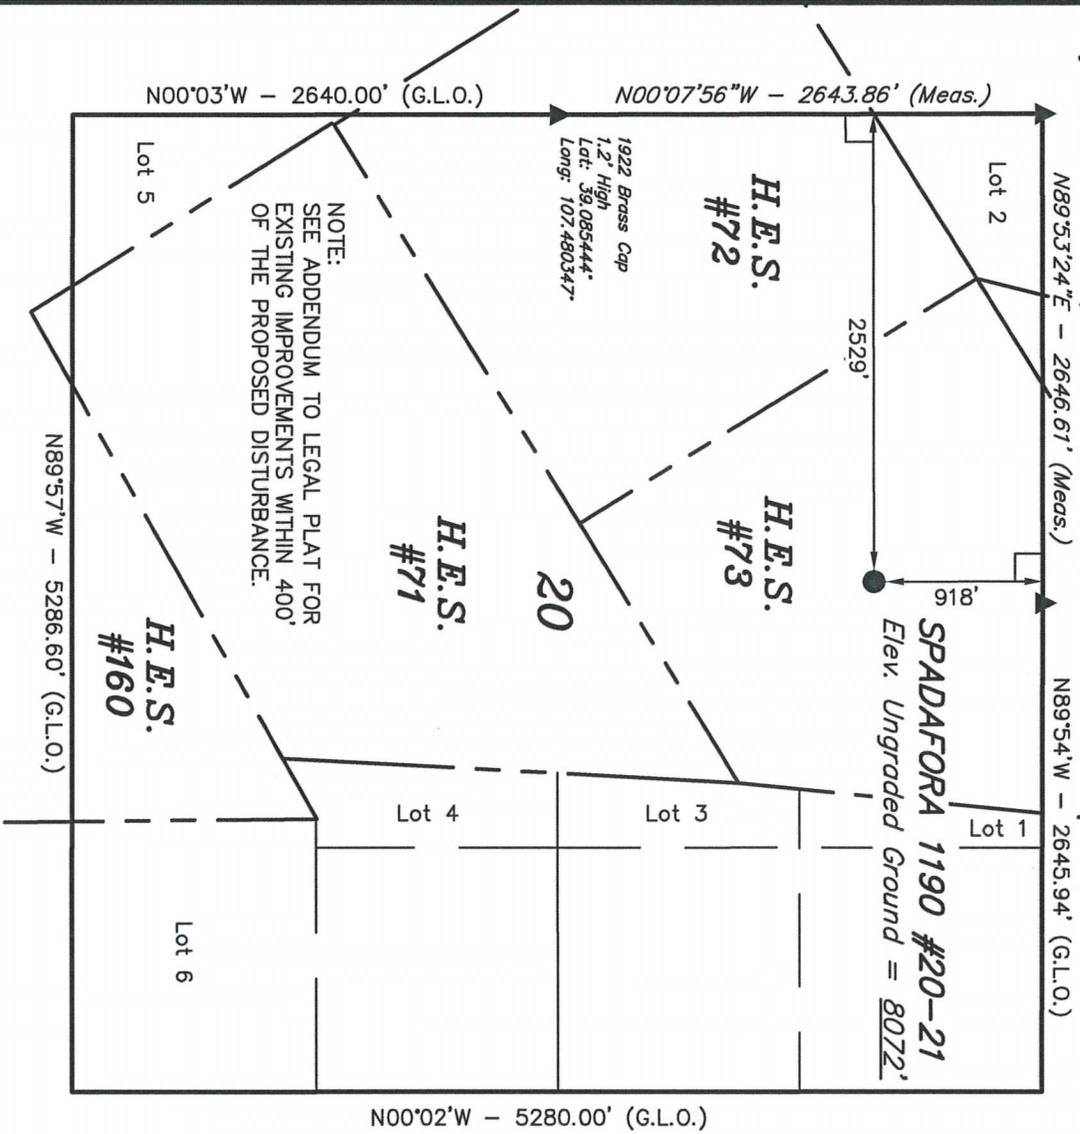

NOTE:  
SEE ADDENDUM TO LEGAL PLAT FOR  
EXISTING IMPROVEMENTS WITHIN 400'  
OF THE PROPOSED DISTURBANCE.

### LEGEND:

- = 90° SYMBOL
- = PROPOSED WELL HEAD.
- ▲ = SECTION CORNERS LOCATED.

MAD 83 (SURFACE LOCATION)	
LATITUDE = 39.0524.70° (39.090194)	
LONGITUDE = 107.2817.25° (107.471456)	
MAD 27 (SURFACE LOCATION)	
LATITUDE = 39.0524.75° (39.090208)	
LONGITUDE = 107.2815.05° (107.470847)	
UTM COORD.: MAD 1927 / ZONE 13	
N = 14204320.438	E = 939294.860

PDOP = 1.8

## GUNNISON ENERGY CORPORATION


Well location, SPADAFORA 1190 #20-21, located as shown in H.E.S. #73 of Section 20, T11S, R90W, 6th P.M., Gunnison County, Colorado.

### BASIS OF ELEVATION

SPOT ELEVATION LOCATED A ROAD INTERSECTION IN THE NE 1/4 OF SECTION 9, T11S, R90W, 6th P.M. TAKEN FROM THE BULL MOUNTAIN QUADRANGLE, COLORADO, GUNNISON COUNTY, 7.5 MINUTE SERIES (TOPO GRAPHICAL MAP) PUBLISHED BY THE UNITED STATES DEPARTMENT OF THE INTERIOR, GEOLOGICAL SURVEY. SAID ELEVATION IS MARKED AS BEING 7487 FEET.

BASIS OF BEARINGS IS A G.P.S. OBSERVATION.

### BASIS OF BEARINGS

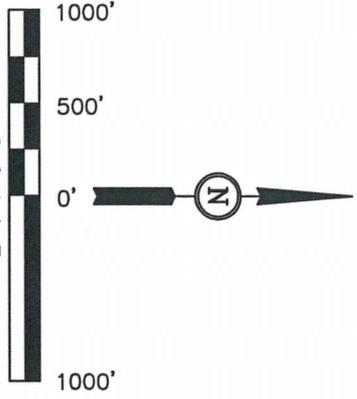

### CERTIFICATE

THIS IS TO CERTIFY THAT THE ABOVE PLAT WAS PREPARED FROM FIELD NOTES OF ACTUAL SURVEYS MADE BY ME OR UNDER MY SUPERVISION AND THAT THE SAME ARE TRUE AND CORRECT TO THE BEST OF MY KNOWLEDGE AND BELIEF.

REGISTERED LAND SURVEYOR  
REGISTRATION NO. 17492  
STATE OF COLORADO

Revised: 03-22-10

**UINTAH ENGINEERING & LAND SURVEYING**  
85 SOUTH 200 EAST - VERNAL, UTAH 84078  
(435) 789-1017


SCALE	1" = 1000'	DATE SURVEYED:	11-18-09	DATE DRAWN:	12-04-09
PARTY	B.H., G.O., C.H.	REFERENCES	G.L.O. PLAT		
WEATHER	COLD	FILE	GUNNISON ENERGY CORPORATION		

**GUNNISON ENERGY CORPORATION**

**ADDENDUM TO LEGAL PLAT FOR**

SPADAFORA 1190 #20-21  
SECTION 20, T11S, R90W, 6th P.M.  
918' FNL 2529' FWL

SCALE: 1" = 200'  
DATE: 12-07-09  
DRAWN BY: C.H.  
REV: 03-25-10

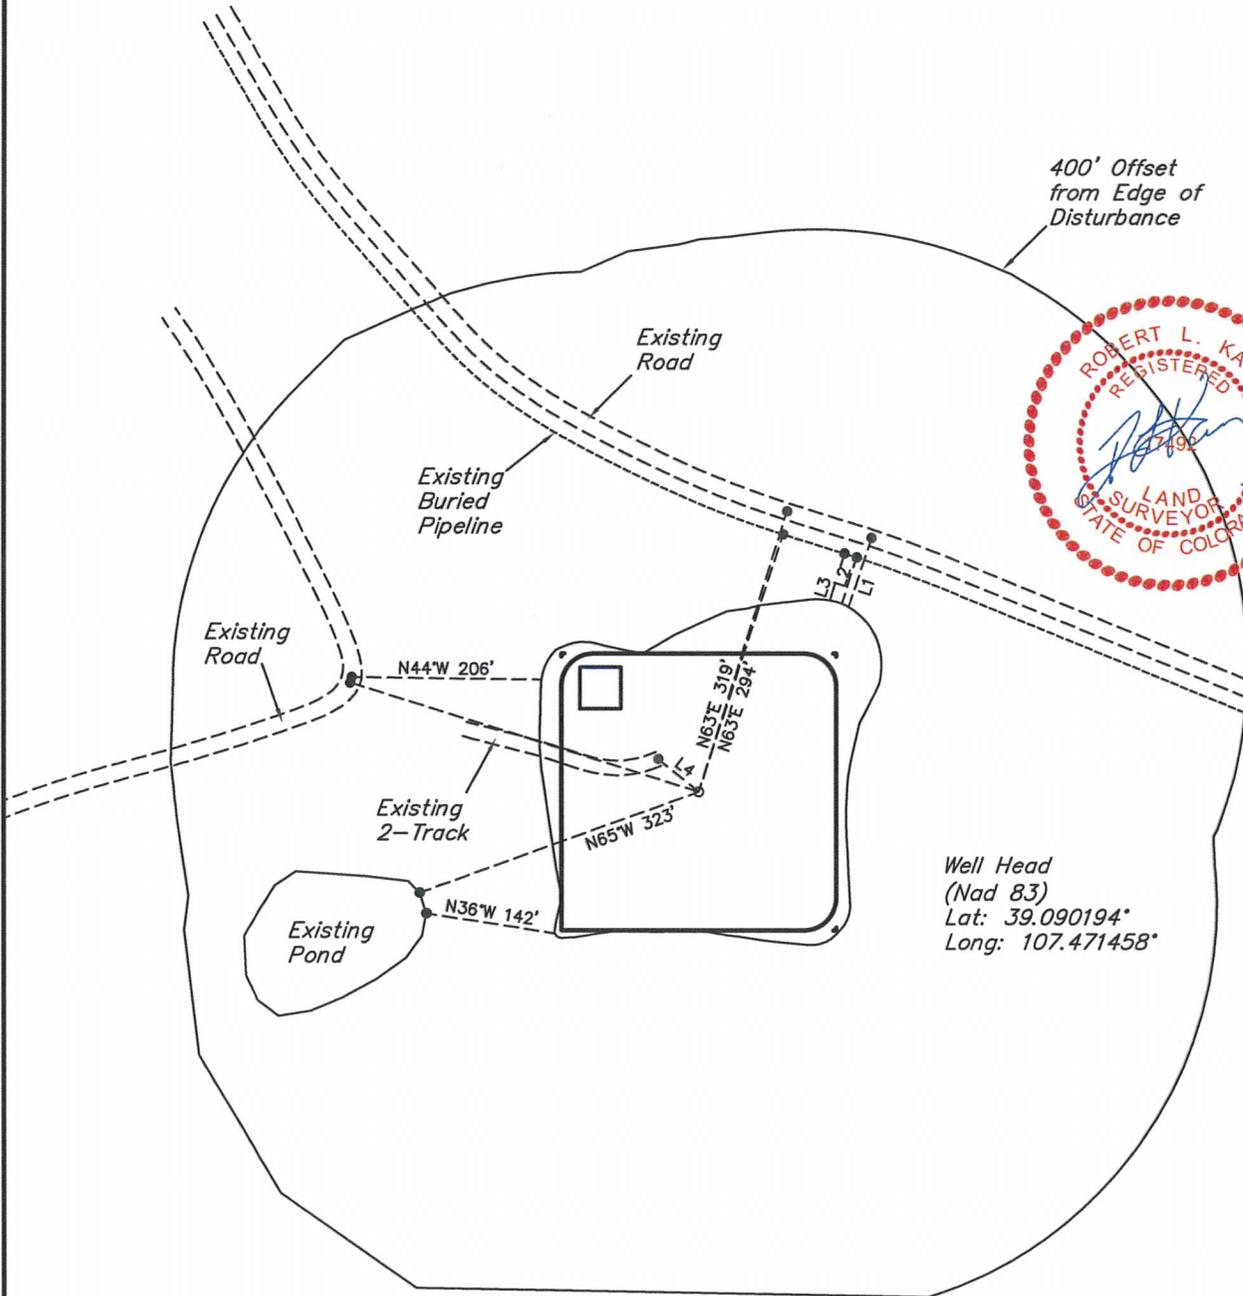

LINE TABLE		
LINE	DIRECTION	LENGTH
L1	N63°E	79'
L2	N62°E	52'
L3	N62°E	53'
L4	N06°W	57'