


LOCATION DRAWING  
SW-NE OF SECTION 9, TOWNSHIP 2 SOUTH  
RANGE 44 WEST, 6TH P.M.

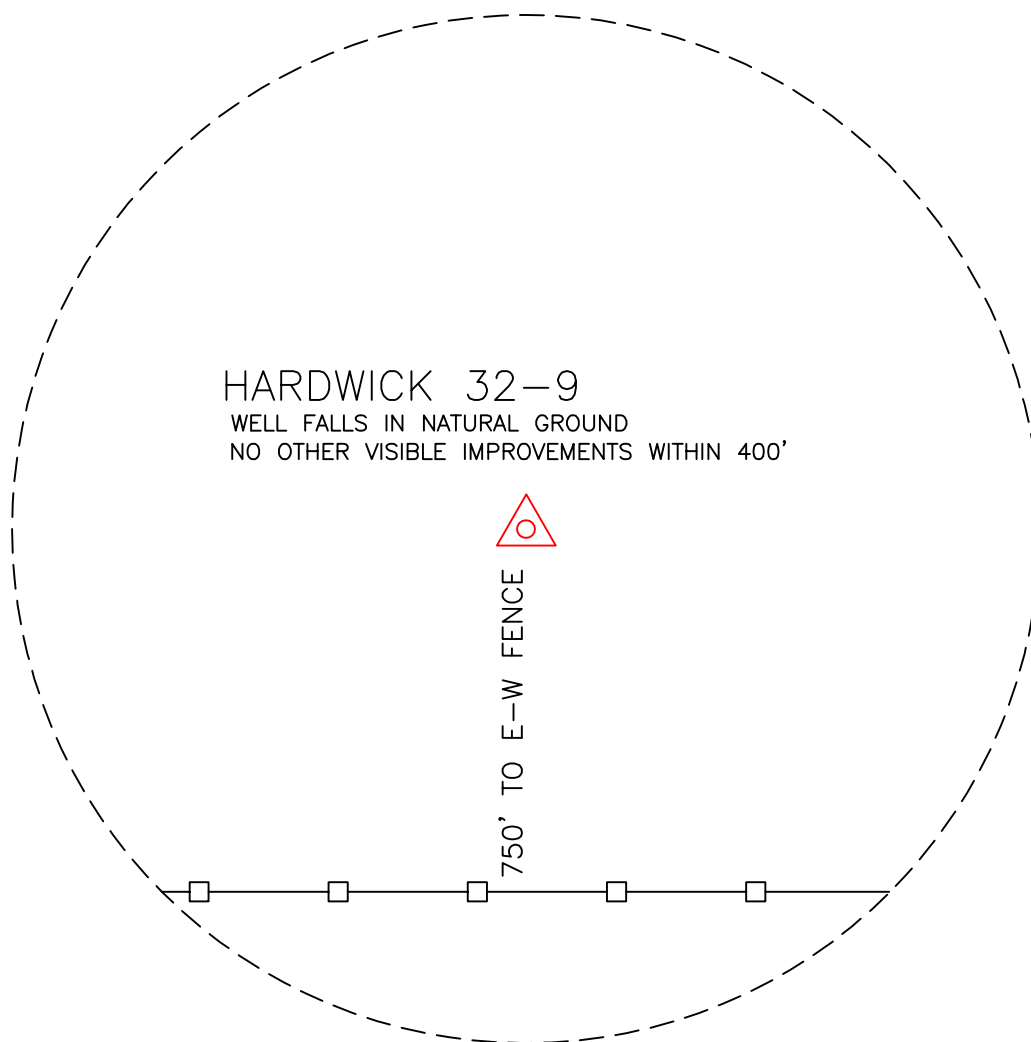

nts

PREPARED BY: DeManche Enterprises	WELL NAME: HARDWICK 32-9
DRAWING DATE: 11/17/09	LOCATION: YUMA COUNTY, COLORADO
FIELD DATE: 11/15/09	SW-NE 1/4 OF SEC 9, T 2 S, R44W, 6TH P.M.