
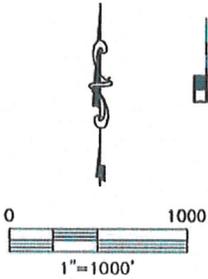


WELL LOCATION CERTIFICATE

THIS MAP DOES NOT REPRESENT A BOUNDARY SURVEY

SECTION: 30  
TOWNSHIP: 6N  
RANGE: 62W

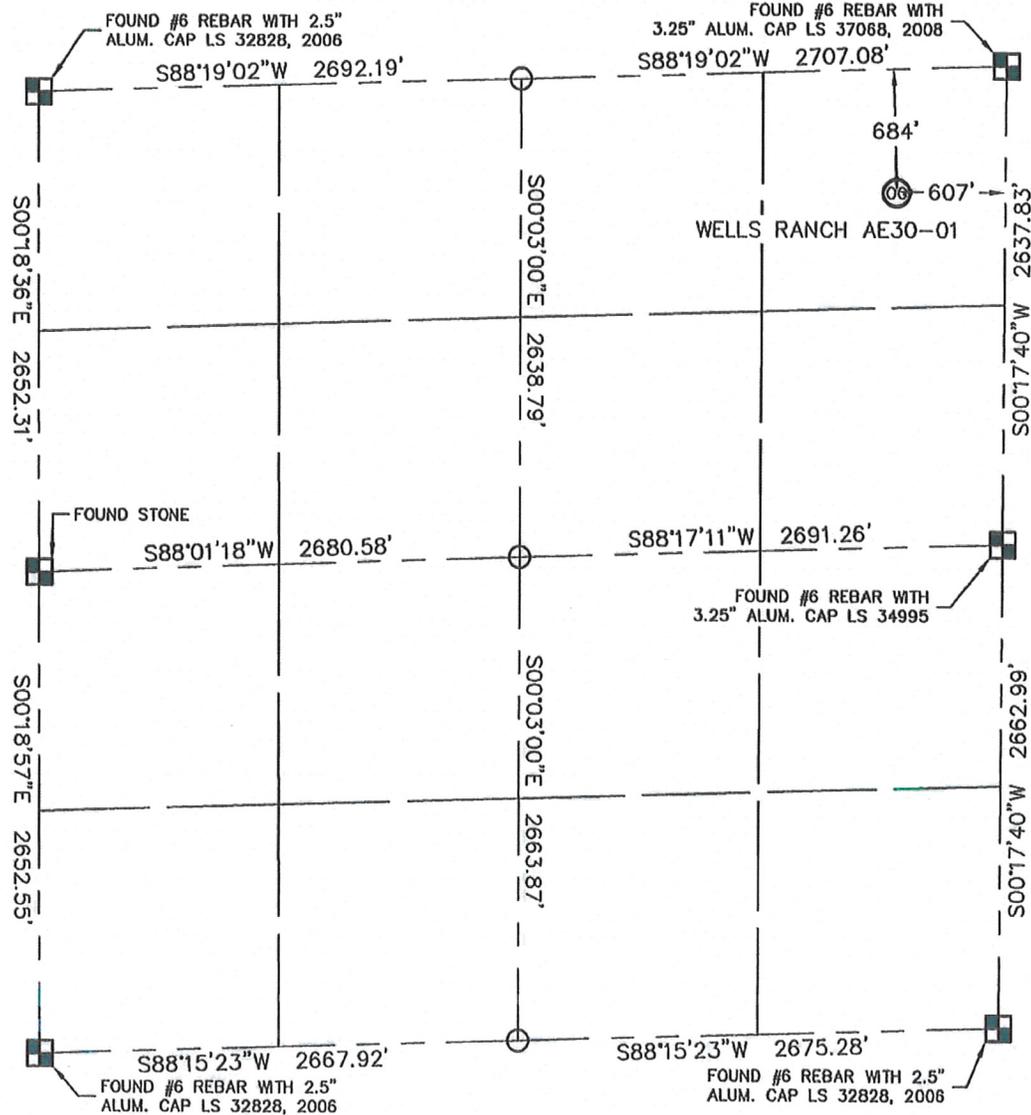

In accordance with a request from Sean Casper with Noble Energy Inc. King Surveyors Inc. has determined the surface location of the WELLS RANCH AE30-01 to be 684' from the NORTH line and 607' from the EAST line as measured at right angles from the section line of Section 30, Township 6 North, Range 62 West of the Sixth Principal Meridian, County of Weld, State of Colorado.

I hereby state that this Well Location Certificate was prepared by me, or under my direct supervision, that the fieldwork was completed on 2-15-10, for and on behalf of Noble Energy Inc. That this is not a Land Survey Plat or an Improvement Survey Plat, and that it is not to be relied upon for establishment of fence, building, or other future improvement lines.

NOTE:

- 1) Bearings shown are Grid Bearings of the Colorado State Plane Coordinate System, North Zone, North American Datum 1983/2007. The lineal dimensions as contained herein are based upon the "U.S. Survey Foot."
- 2) Ground elevations are based on an observed GPS elevation (NAVD 1988 DATUM).
- 3) NEAREST EXISTING WELL: NONE IN THE SECTION
- 4) IMPROVEMENTS: See VISIBLE IMPROVEMENTS exhibit for all visible improvements within 600' of well head.
- 5) SURFACE USE: DRYLAND PASTURE


SURFACE LOCATION  
 LATITUDE: 40.463051N  
 LONGITUDE: 104.35841W  
 PDOP: 1.4  
 ELEV: 4772  
 1/4, 1/4: NE1/4NE1/4  
 NEAREST PROPERTY LINE: 607' EAST

NOTE

According to Colorado law, you must commence any legal action based upon any defect in this W.L.C. within three years after you discover such defect. In no event, may any action based upon any defect in this survey be commenced more than ten years after the date of the certificate shown hereon. (13-80-105 C.R.S.)

LEGEND


-  = ALIQUOT MONUMENT AS DESCRIBED
-  = CALCULATED POSITION

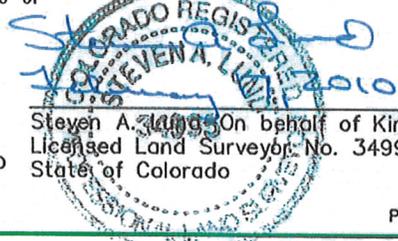

Steven A. Linn On behalf of King Surveyors, Inc.  
 Licensed Land Surveyor No. 34995  
 State of Colorado

# SITE SKETCH

SECTION: 30  
TOWNSHIP: 6N  
RANGE: 62W

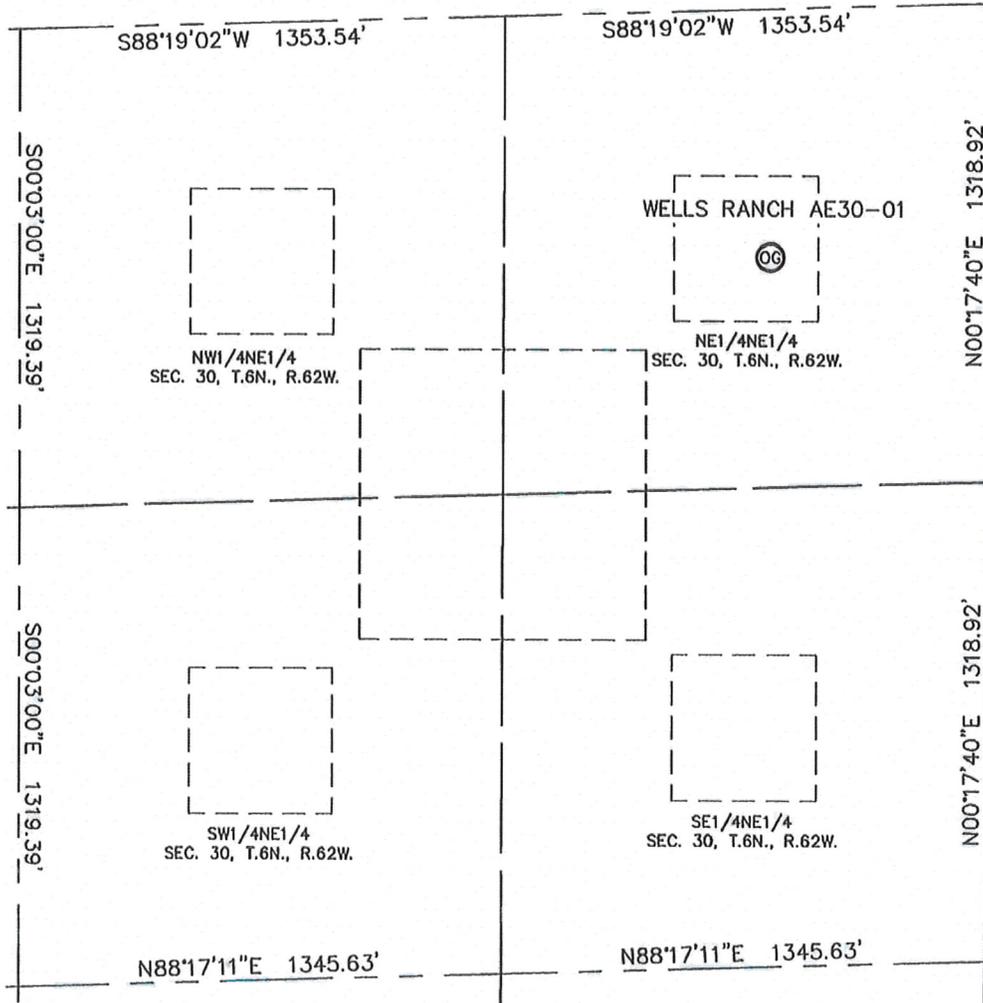

NO EXISTING WELLS

