

Steil Surveying Services, LLC


1102 West 19th Street P.O. BOX 2073

Cheyenne, Wyoming 82009

HYDROLOGY MAP


THIS MAP DOES NOT REPRESENT A BOUNDARY SURVEY

SECTION 15
TOWNSHIP 7 NORTH
RANGE 64 WEST

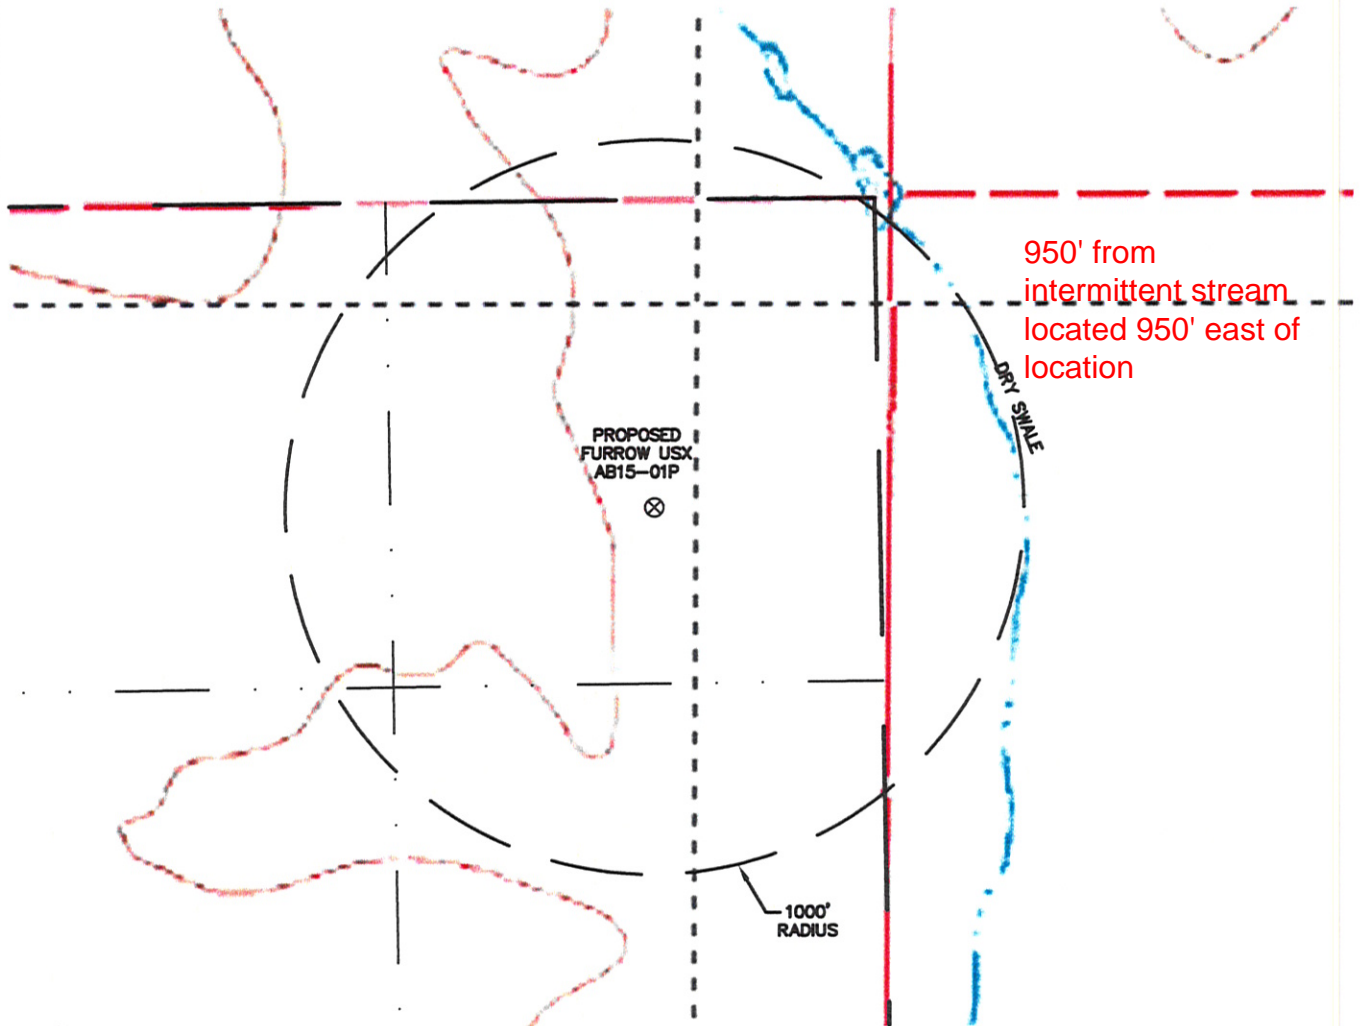

THERE IS NO VISIBLE SURFACE WATER WITHIN 1000'.

DATE: 02/12/2010

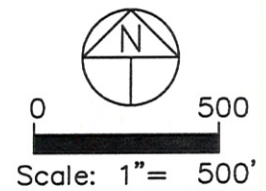

Zones: C/N/L/Y/ONS
Surf Csg: 750' 9 5/8" 36# J55 165 sxs
TD/MD: 9150' 7" 26# L80 622 sxs