
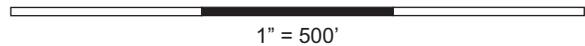


T 4 N R 59 W Sec 25 NESE

Access Map High Plains 25-9 Tank Battery

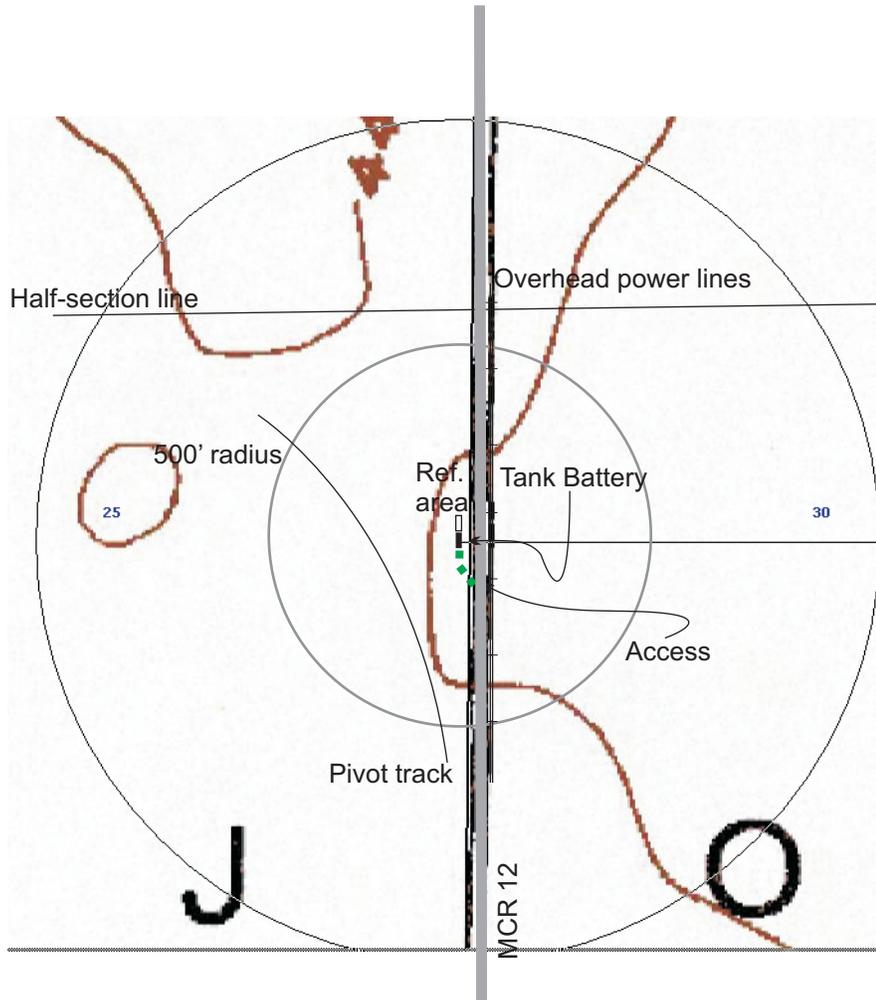

Edge of road is 20' east
Power lines are 53' east
Irrigation pivot track is S63°W 200'