


Power Surveying Co., Inc. of Frederick, Colorado has in accordance with a request from SHERRY GLASS for KP KAUFFMAN determined the location of KAMMERZELL 7-7-24 to be 2031' FNL & 1829' FEL Section 7, Township 4 NORTH Range 66 WEST of the Sixth Principal Meridian, WELD County, Colorado

LOCATION NOTES

LOCATION FALLS IN: PASTURE
 IMPROVEMENTS: EXISTING WELL 50' NW OF LOCATION, SEPARATOR 145' NORTH OF LOCATION, E-W FENCE 121' NORTH OF LOCATION
 ELEVATION DETERMINED FROM NAVD 1988 DATUM. GROUND ELEVATION = 4730'
 DISTANCES AND BEARINGS ARE FIELD MEASURED UNLESS OTHERWISE NOTED.

LEGEND

- SECTION CORNER (AS NOTED)
- ▼ PROPOSED WELL LOCATION
- ⊗ BOTTOM OF HOLE LOCATION.

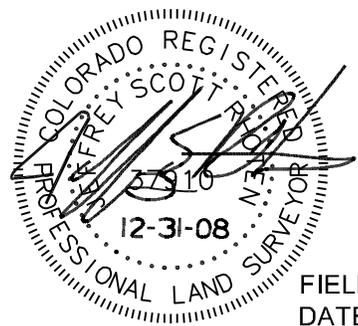

7800 MILLER DRIVE UNIT C
 FREDERICK, COLORADO 80504
 303-702-1617

Jeffery Scott Rhoten
 COLORADO P.L.S. #37910

FIELD DATE: 12-18-06 WO# 501-06-1120A
 DATE OF COMPLETION: 12-31-08