


KING SURVEYORS, INC. 650 GARDEN DR. WINDSOR, CO 80550
VISIBLE IMPROVEMENTS

SECTION: 23
TOWNSHIP: 4N
RANGE: 66W

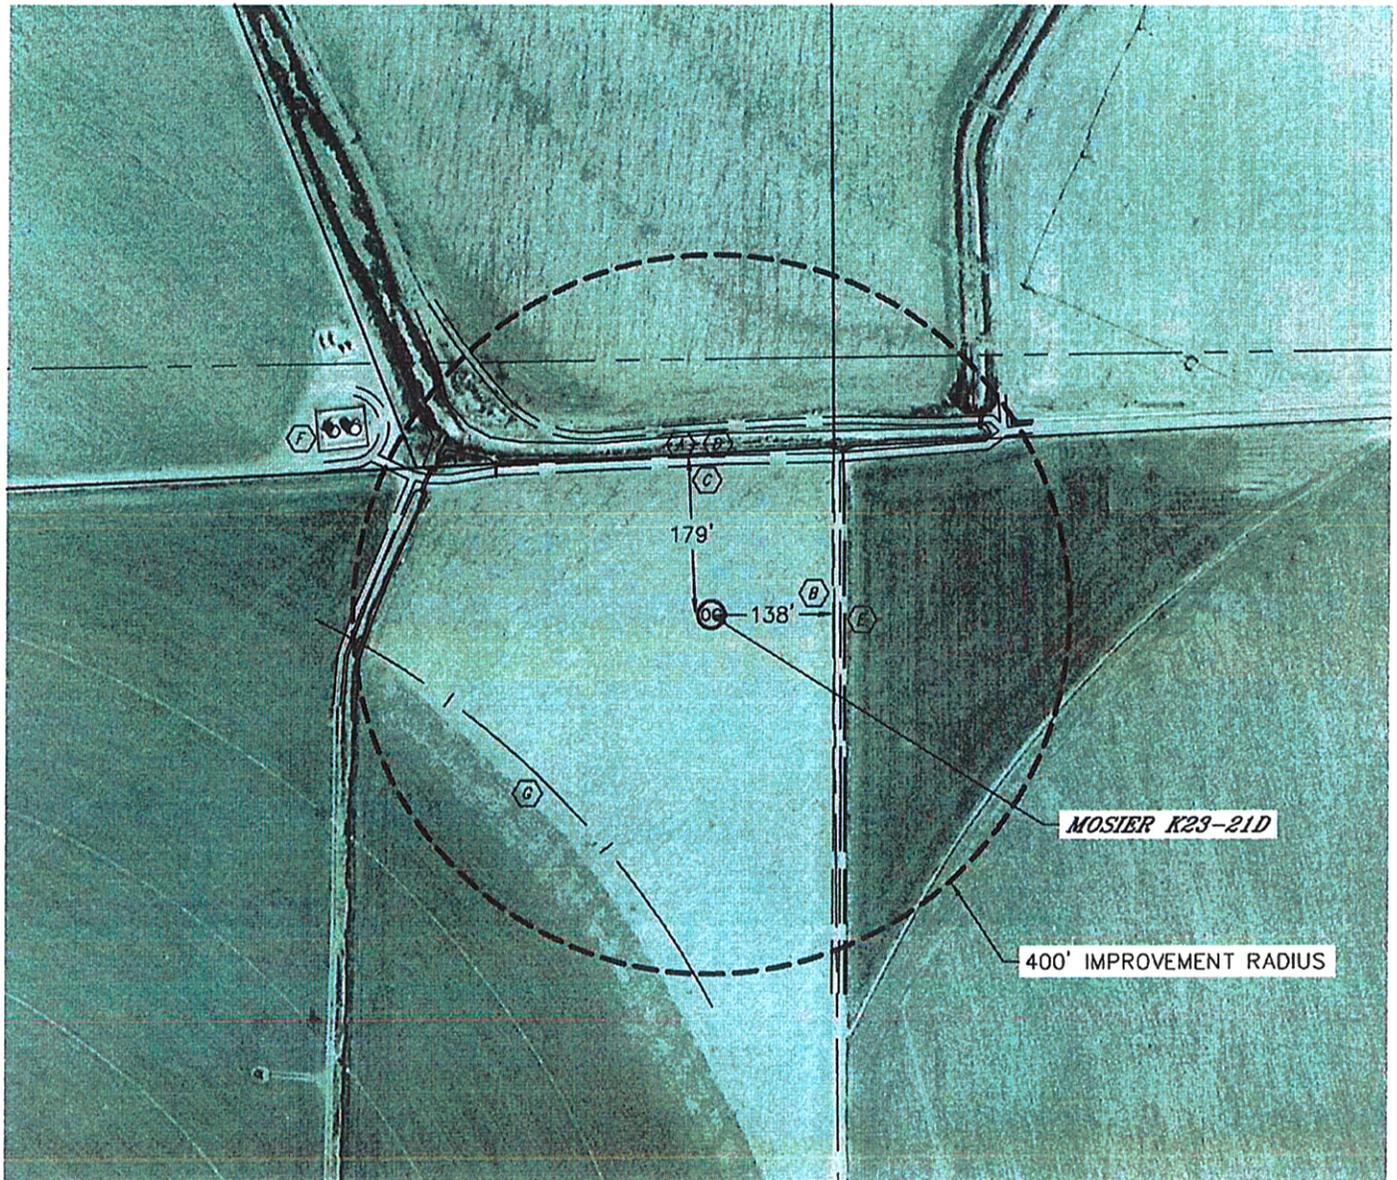

IMPROVEMENTS:

- (A) PROPERTY LINE 138' EAST
- (B) PROPERTY LINE 368' NORTHWEST, 231' NORTHEAST, 179' NORTH
- (C) FIELD ROAD 141' EAST, 171' NORTH, 209' NORTH, 367' NORTHWEST
- (D) IRRIGATION CANAL 179' NORTH, 346' NORTHWEST
- (E) DIRT DITCH 149' EAST
- (F) TANK BATTERY ENCLOSURE 428' NORTHWEST
- (G) IRRIGATION PIVOT TRACK 262' SOUTHWEST

